


STATE OF KANSAS  
STATE CORPORATION COMMISSION

15-065-19078-00-00

Give All Information Completely  
Make Required Affidavit  
Mail or Deliver Report to:  
Conservation Division  
State Corporation Commission  
800 Biting Building  
Wichita, Kansas

WELL PLUGGING RECORD

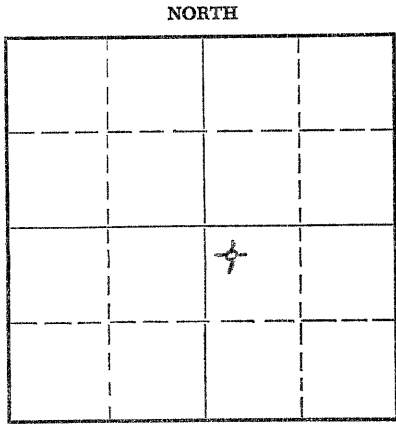

Locate well correctly on above  
Section Plat

Graham County. Sec. 21 Twp. 8S Rge. (E) 23(W)  
Location as "NE/CNW/SW" or footage from lines NW NW SE  
Lease Owner Peel-Hardman Oil Producers  
Lease Name Legere Well No. 1  
Office Address \_\_\_\_\_  
Character of Well (completed as Oil, Gas or Dry Hole) Oil  
Date well completed Nov. 2 19 51  
Application for plugging filed 11-19 19 54  
Application for plugging approved 11-19 19 54  
Plugging commenced Feb. 2 19 55  
Plugging completed Feb. 25 19 55  
Reason for abandonment of well or producing formation No longer a commercial producer.  
If a producing well is abandoned, date of last production 1-6 19 55  
Was permission obtained from the Conservation Division or its agents before plugging was commenced? Yes

Name of Conservation Agent who supervised plugging of this well Eldon Petty  
Producing formation Kansas City Depth to top 3761' Bottom \_\_\_\_\_ Total Depth of Well 4080 Feet  
Show depth and thickness of all water, oil and gas formations.

OIL, GAS OR WATER RECORDS

CASING RECORD

FORMATION	CONTENT	FROM	TO	SIZE	PUT IN	PULLED OUT
		0	273'	8 5/8"	273	None
		0	3823'	5 1/2"	3823'	2407'

Describe in detail the manner in which the well was plugged, indicating where the mud fluid was placed and the method or methods used in introducing it into the hole. If cement or other plugs were used, state the character of same and depth placed, from \_\_\_\_\_ feet to \_\_\_\_\_ feet for each plug set.

Filled back with chat to 3690'. Dumped 4 sacks of cement. Shot pipe off at 2407'. Pulled pipe and mudded hole to 270'. Set rock bridge and dumped 15 sacks of cement. Finished mudding hole to 35'. Dumped 10 sacks of cement.

(If additional description is necessary, use BACK of this sheet)  
Name of Plugging Contractor Bert Self  
Address R.F.D. #4, Hutchinson, Kansas

STATE OF Kansas, COUNTY OF Barton, ss.  
William Herbert Employee (employee of owner) or (~~owner or operator~~) of the above-described well, being first duly sworn on oath, says: That I have knowledge of the facts, statements, and matters herein contained and the log of the above-described well as filed and that the same are true and correct. So help me God.

(Signature) [Signature]  
P. O. Box 359, Hoisington, Kansas  
(Address)

SUBSCRIBED AND SWORN TO before me this 3rd day of March, 19 55

My commission expires June 4, 1955

[Signature] Notary Public.

24-7368-S 3-53-20M

**PLUGGING**  
FILE SEC 21 T 8 R 23W  
PAGE 29 LINE 2

**RECEIVED**  
STATE CORPORATION COMMISSION

MAR 4 1955

CONSERVATION DIVISION  
Wichita, Kansas

34-55

15-065-19078-00-00

DRILLER'S LOG

Company: Peel-Hardman Oil Producers  
Farm Name; Legere Estate Well No. 1  
Total Depth: 4080'

NW NW SE  
Sec. 21, Twp. 8S, Rge 23W  
County: Graham, Kansas

Comm: 10-16-51 Comp: 10-27-51  
Contractor: Glenn W. Peel

Elevation:

Casing: 8-5/8" 273' cem.  
5-1/2" 3823' cem.

Production:

Figures below indicate bottoms of formations:

Surface Soil	0 -	35
Clay and Shale		75
Sand		135
Shale and Shells		270
Shale		1175
Sand and Shale		1250
Shale and Shells		1450
Sand and Shale Streaks		1770
Shale		1890
Red Bed		1925
Shale and Shells		1945
Anhydrite		1985
Shale and Shells		2410
Shale and Lime Streaks		2640
Shale and Shells		2800
Shale and Lime		2940
Lime		3907
Shale and Lime		3940
Lime		3990
Lime and Conglomerate		4041
Lime		4080
Total Depth		4080

This is to certify that the above information is to the best of our knowlege, true and correct.

GLENN W. PEEL

BY *Glenn W. Peel*

SUBSCRIBED AND SWORN to before me this 28<sup>th</sup> day of October, 1951.

My commission expires: June 4, 1955

*Marion M. Herbert*  
Notary Public

11-22-54

PLUGGING  
WELL SEC 21 T 8 R 23W  
BOOK PAGE 29 LINE 2