

15-065-30163-00-00


STATE OF KANSAS  
STATE CORPORATION COMMISSION

WELL PLUGGING RECORD

Give All Information Completely  
Make Required Affidavit  
Mail or Deliver Report to:  
Conservation Division  
State Corporation Commission  
212 No. Market  
Wichita, Kansas

Graham County, Sec. ~~28~~<sup>23</sup> Twp. 8S Rge. 23 (E) W (W)  
Location as "NE/CNW/SW" or footage from lines NW NE SE  
Lease Owner John P. Jennings  
Lease Name Radcliffe Well No. 1  
Office Address 311 Union Center, Wichita, Kansas 67202  
Character of Well (completed as Oil, Gas or Dry Hole) Dry Hole  
Date well completed October 10 19 66  
Application for plugging filed October 10 19 66  
Application for plugging approved October 10 19 66  
Plugging commenced October 10 19 66  
Plugging completed October 10 19 66  
Reason for abandonment of well or producing formation Dry hole

NORTH

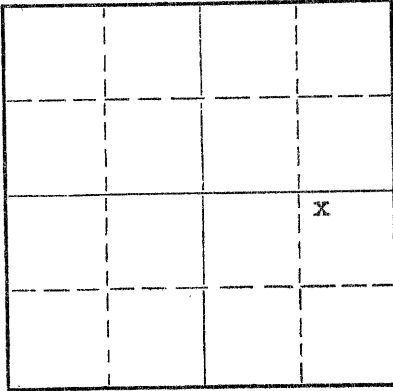

Locate well correctly on above  
Section Plat

If a producing well is abandoned, date of last production 19  
Was permission obtained from the Conservation Division or its agents before plugging was commenced? Yes

Name of Conservation Agent who supervised plugging of this well W. L. Nichol, Morland, Kansas  
Producing formation \_\_\_\_\_ Depth to top \_\_\_\_\_ Bottom \_\_\_\_\_ Total Depth of Well 3605 Feet  
Show depth and thickness of all water, oil and gas formations.

OIL, GAS OR WATER RECORDS

CASING RECORD

FORMATION	CONTENT	FROM	TO	SIZE	PUT IN	PULLED OUT
		0	270	7"	270	0

Describe in detail the manner in which the well was plugged, indicating where the mud fluid was placed and the method or methods used in introducing it into the hole. If cement or other plugs were used, state the character of same and depth placed, from \_\_\_\_\_ feet to \_\_\_\_\_ feet for each plug set.

Hole plugged with heavy mud and 15 sx cement @ 450;  
15 sx cement @ 270'; 10 sx cement @ 40' to surface.

OCT 17 1966  
CONSERVATION DIVISION  
Wichita, Kansas  
10/17/66

(If additional description is necessary, use BACK of this sheet)

Name of Plugging Contractor Paine Drilling Co., Inc.  
Address P. O. Box D, Hill City, Kansas

STATE OF Kansas, COUNTY OF Graham, ss.  
D. F. McCarthy (employee of owner) or (town or operator) of the above-described

well, being first duly sworn on oath, says: That I have knowledge of the facts, statements, and matters herein contained and the log of the above-described well as filed and that the same are true and correct. So help me God.

(Signature) D. F. McCarthy  
P. O. Box D, Hill City, Kansas 67642  
(Address)

SUBSCRIBED AND SWORN to before me this 13 day of October, 1966

My commission expires April 25, 1968  
Donald Law Notary Public

15-065-30163-00-00

CONTRACTOR'S WELL LOG

COMPANY:  
CONTRACTOR:  
WELL:  
LOCATION:  
COMMENCED:  
COMPLETED:

John P. Jennings  
Paine Drilling Co., Inc.  
Radcliffe # 1 23  
NW NE SE Section 30-8S-23W  
Graham County, Kansas  
September 29, 1966  
October 10, 1966

270	Sand & Shale
1000	Shale & Sand
1757	Shale, Sand & Red Bed
1793	Anhydrite
2367	Shale & Shells
3360	Shale & Lime
3605	Shale & Lime
3605	Rotary Total Depth

REGISTRATION DIVISION  
OCT 17 1966  
10/17/66  
WICHITA, KANSAS

Set 7" Surface Casing @ 270' with 150 sx cement.

Dry & Abandoned.

We hereby certify that the above is a correct and accurate log of the above mentioned well, as shown on the daily drilling reports.

PAINE DRILLING CO., INC.

BY: A. J. McCarthy  
Treasurer

Subscribed and sworn to before me this 13th day of October, 1966.

Donald Law  
Notary Public

My Commission Expires May 25, 1968