


STATE OF KANSAS  
STATE CORPORATION COMMISSION

15-065-02330-00-00

Give All Information Completely  
Make Required Affidavit  
Mail or Deliver Report to:  
Conservation Division  
State Corporation Commission  
211 No. Broadway  
Wichita, Kansas

WELL PLUGGING RECORD

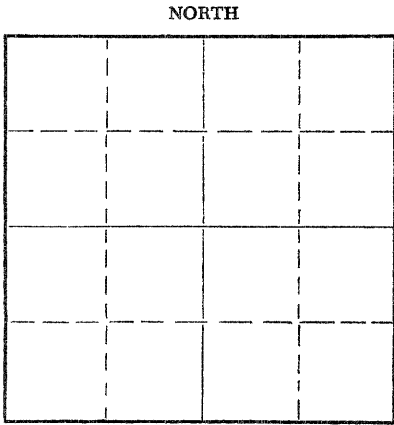

Locate well correctly on above  
Section Plat

Graham County. Sec. 24 Twp. 8S Rge. (E) 23 (W)  
Location as "NE/CNW&SW&" or footage from lines SE SE NW  
Lease Owner Sunray Mid-Continent Oil Company  
Lease Name Findley Law Well No. 1  
Office Address Box 788, Great Bend, Kansas  
Character of Well (completed as Oil, Gas or Dry Hole) Dry Hole  
Date well completed June 21 19 58  
Application for plugging filed June 23 19 58  
Application for plugging approved June 24 19 58  
Plugging commenced June 21 19 58  
Plugging completed June 21 19 58  
Reason for abandonment of well or producing formation \_\_\_\_\_

If a producing well is abandoned, date of last production \_\_\_\_\_ 19 \_\_\_\_\_  
Was permission obtained from the Conservation Division or its agents before plugging was commenced? Yes

Name of Conservation Agent who supervised plugging of this well A. D. Fabricius  
Producing formation \_\_\_\_\_ Depth to top \_\_\_\_\_ Bottom \_\_\_\_\_ Total Depth of Well 3626 Feet  
Show depth and thickness of all water, oil and gas formations.

OIL, GAS OR WATER RECORDS

CASING RECORD

FORMATION	CONTENT	FROM	TO	SIZE	PUT IN	PULLED OUT
				8 5/8	230	none

Describe in detail the manner in which the well was plugged, indicating where the mud fluid was placed and the method or methods used in introducing it into the hole. If cement or other plugs were used, state the character of same and depth placed, from \_\_\_\_\_ feet to \_\_\_\_\_ feet for each plug set.

Filled hole with drilling mud, set plug at 600' with 25 sacks cement. Filled hole with cement, set plug at 220' with 15 sacks cement. Filled hole with mud, set plug at 40' with 10 sacks cement. Plugging completed.

Log attached.

RECEIVED  
STATE CORPORATION COMMISSION  
JUL 1 - 1958  
CONSERVATION DIVISION  
WICHITA, KANSAS

(If additional description is necessary, use BACK of this sheet)  
Name of Plugging Contractor Halliburton Oil Well Cementing Company 7-1-58  
Address \_\_\_\_\_

STATE OF Kansas, COUNTY OF Barton, ss.  
N. E. Montgomery (employee of owner) or (~~owner or operator~~) of the above-described well, being first duly sworn on oath, says: That I have knowledge of the facts, statements, and matters herein contained and the log of the above-described well as filed and that the same are true and correct. So help me God.

(Signature) N. E. Montgomery  
Box 788, Great Bend, Kansas  
(Address)

SUBSCRIBED AND SWORN TO before me this 30th day of June, 19 58

My commission expires December 24, 1960

Notary Public.

PLUGGING  
FILE SEC 24 T. B R 23W  
BOOK PAGE 110 LINE 12

Sunray Mid-Continent Oil Company  
Tulsa, Oklahoma

Tulsa, Oklahoma  
June 23, 1958

CONTRACTOR: Stickle Drilling Company  
Drilling Commenced: June 14, 1958  
Drilling Completed: June 22, 1958

Findley Law #1 NW/4  
Sec. 24-8S-23W,  
Graham County, Kansas.

15-065-02330-0000

DRILLERS LOG

Depth Figures Indicate Base of Formation:

Surface	0
Clay & Sand	100
Shale & Shells	870
Sand & Shale	950
Shale, Shells & Sand Streak	1320
Sand	1520
Shale & Shells	1770
Anhydrite	1800
Shale & Shells	2390
Shale & Lime	2845
Lime & Shale	2965
Shale & Lime	5207
Lime & Shale	3190
Shale & Lime	3405
Lime	3625 TD

I, Frank E. Stickle hereby certify the above to be a true and complete Drillers Log of Sunray Mid-Continent Oil Company's Findley Law #1 NW/4 Section 24-8S-23W, Graham County, Kansas.

Lillian T. Bonham  
Notary Public

Frank E. Stickle  
Frank E. Stickle

February 13, 1960  
My Commission Expires

PLUGGING			
FILE	SEC. 24	B	23W
BOOK	PAGE 110	LINE	12

77-58