

15-065-00806-00-00


STATE OF KANSAS
STATE CORPORATION COMMISSION

WELL PLUGGING RECORD

Give All Information Completely
Make Required Affidavit
Mail or Deliver Report to:
Conservation Division
State Corporation Commission
211 No. Broadway
Wichita, Kansas

Graham County, Sec. 6 Twp. 8 Rge. 22W (E) (W)
Location as "NE/CNW/SW" or footage from lines C SE NW

NORTH

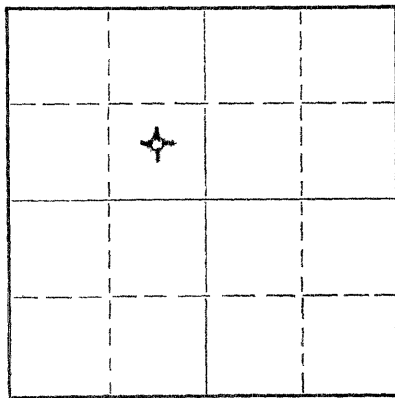

Locate well correctly on above
Section Plat

Lease Owner D. G. Hansen
Lease Name J. A. Jones Well No. 1
Office Address Logan, Kansas
Character of Well (completed as Oil, Gas or Dry Hole) Dry Hole
Date well completed March 2 19 59
Application for plugging filed March 2 19 59
Application for plugging approved March 2 19 59
Plugging commenced March 2 19 59
Plugging completed March 2 19 59
Reason for abandonment of well or producing formation Too low structurally

If a producing well is abandoned, date of last production 19
Was permission obtained from the Conservation Division or its agents before plugging was commenced? Yes

Name of Conservation Agent who supervised plugging of this well Eldon Petty, Hays, Kansas
Producing formation _____ Depth to top _____ Bottom _____ Total Depth of Well 3755 Feet
Show depth and thickness of all water, oil and gas formations.

OIL, GAS OR WATER RECORDS

CASING RECORD

FORMATION	CONTENT	FROM	TO	SIZE	PUT IN	PULLED OUT
				8-5/8"	200.68'	none

Describe in detail the manner in which the well was plugged, indicating where the mud fluid was placed and the method or methods used in introducing it into the hole. If cement or other plugs were used, state the character of same and depth placed, from _____ feet to _____ feet for each plug set.

Filled hole with heavy mud to 600'. Set plug. Put in 20 sacks cement. Filled to 195'. Set plug. Put in 1/2 sack hulls and 20 sacks cement. Filled with heavy mud up to 40'. Set plug. Filled to top with 1/2 sack hulls and 10 sacks cement.

RECEIVED
STATE CORPORATION COMMISSION

MAR 25 1959

CONSERVATION DIVISION
Wichita, Kansas

(If additional description is necessary, use BACK of this sheet)
Name of Plugging Contractor C-G Drilling Co. 3-25-59
Address 107 Rule Building, Wichita, Kansas

STATE OF KANSAS, COUNTY OF SEDGWICK, ss.
G. F. Galloway (employee of owner) or (owner or operator) of the above-described well, being first duly sworn on oath, says: That I have knowledge of the facts, statements, and matters herein contained and the log of the above-described well as filed and that the same are true and correct. So help me God.

(Signature) G. F. Galloway
(Address) 107 Rule Building

SUBSCRIBED AND SWORN TO before me this 6th day of March, 1959

My commission expires May 20, 1959
Vicky Jacobs Notary Public.

PLUGGING
FILE SEC. 6 T. 6 R. 22W
BOOK PAGE 23 LINE 37

15-065-00806-00-00

D. G. Hansen

6-8-22W

J. A. Jones #1

C SE NW

3755'

Graham

February 23, 1959 COMP. March 2, 1959

Kansas

#1

2270' K.B.

Ran 200.68' (10 jts.) 8-5/8" OD Surface Casing.

D & A


0	435	Sand-Shale	
435	1000	Sand-Shale	
1000	1300	Sand	
1300	1913	Red Bed	
1913	1949	Anhydrite	
1949	2330	Shell-Shale	
2330	2500	Shale-Shell	0° - 2500
2500	2800	Shale-Lime	0° - 2750
2800	2925	Lime-Shale	
2925	3190	Shale-Lime	0° - 3000
3190	3290	Lime-Shale	0° - 3250
3290	3498	Lime	
3498	3573	Lime-Shale	
3573	3642	Lime	
3642	3699	Lime-Shale	
3699	3755	Lime	

DST 3678-3730'

RECEIVED
STAT. CORPORATION COMMISSION

MAR 25 1959

CONSERVATION DIVISION
Wichita, Kansas

3-25-59

G. F. Galloway
G. F. Galloway

6th March

Lucky Jacobs

PLUGGING
FILE SEC 6 T 8 R22W
BOOK PAGE 23 LINE 37