


WELL PLUGGING RECORD

Give All Information Completely  
Make Required Affidavit  
Mail or Deliver Report to:  
Conservation Division  
State Corporation Commission  
211 West Broadway  
Wichita, Kansas P. O. Box 17027  
67217

Graham County, Sec. 7 Twp. 8S Rge. (E) 22 (W)  
Location as "NE/CNW/SW" or footage from lines SW NW SW  
Lease Owner Landes Exploration Co.  
Lease Name Casey Jones Well No. 1  
Office Address P. O. Box 867, Magnolia, Arkansas 71753  
Character of Well (completed as Oil, Gas or Dry Hole) Dry Hole  
Date well completed May 1 19 72  
Application for plugging filed May 1 19 72  
Application for plugging approved May 1 19 72  
Plugging commenced May 1 19 72  
Plugging completed May 1 19 72  
Reason for abandonment of well or producing formation Dry Hole

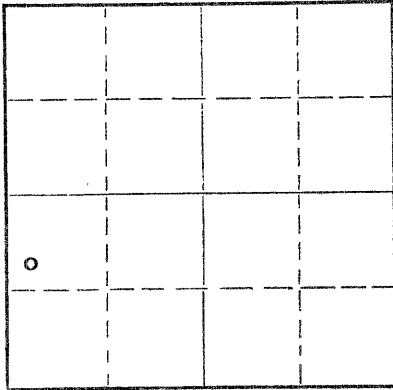

Locate well correctly on above Section Plat

If a producing well is abandoned, date of last production 19  
Was permission obtained from the Conservation Division or its agents before plugging was commenced? Yes

Name of Conservation Agent who supervised plugging of this well W. L. Nichols, Morland, Kansas  
Producing formation \_\_\_\_\_ Depth to top \_\_\_\_\_ Bottom \_\_\_\_\_ Total Depth of Well 3486' Feet  
Show depth and thickness of all water, oil and gas formations.

OIL, GAS OR WATER RECORDS

CASING RECORD

FORMATION	CONTENT	FROM	TO	SIZE	PUT IN	PULLED OUT
		0	206'	8 5/8"	206'	None

Describe in detail the manner in which the well was plugged, indicating where the mud fluid was placed and the method or methods used in introducing it into the hole. If cement or other plugs were used, state the character of same and depth placed, from \_\_\_\_\_ feet to \_\_\_\_\_ feet for each plug set.

Plug: 775' w/70 sacks cement  
245' w/30 sacks cement  
40' w/10 sacks cement

RECEIVED  
STATE CORPORATION COMMISSION  
MAY 8 - 1972  
MAY 8 - 1972  
CONSERVATION DIVISION  
Wichita, Kansas


(If additional description is necessary, use BACK of this sheet)

Name of Plugging Contractor Hellar Drilling Company, Inc.  
Address 339 Union Center Bldg., Wichita, Kansas 67202

STATE OF Kansas, COUNTY OF Sedgwick, ss.  
D. L. Hellar, President of Hellar Drlg. Co., Inc. (employee of owner) or (owner or operator) of the above-described well, being first duly sworn on oath, says: That I have knowledge of the facts, statements, and matters herein contained and the log of the above-described well as filed and that the same are true and correct. So help me God.

(Signature) [Signature] D. L. Hellar, President  
339 Union Center Bldg., Wichita, Kansas 67202  
(Address)

SUBSCRIBED AND SWORN TO before me this 5th day of May, 19 72

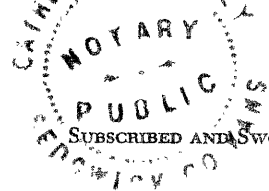

Catherine Darcey  
Catherine Darcey Notary Public.

My commission expires March 25, 1976

DRILLER'S LOG

COMPANY: Landes Exploration Co., P. O. Box 867, Magnolia, Arkansas 71753  
 CONTRACTOR: Hellar Drilling Company, Inc., 339 Union Center Bldg., Wichita, Ks.67202  
 LEASE: #1 Casey Jones  
 LOCATION: SW NW SW 7-8S-22W, Graham County, Kansas  
 COMMENCED: April 27, 1972  
 COMPLETED: May 1, 1972  
 CASING: Set 8 5/8" Surface Casing @ 206' w/150 sacks cement

0-207	Surface Soil - Sand & Shale
207-430	Sand & Shale
430-1370	Shale w/Sand Streaks
1370-1580	Shale
1580-1827	Red Bed & Shale & Sand
1827-1857	Anhydrite
1857-2340	Salt Section & Shale
2340-2630	Shale & Lime
2630-2908	Lime
2908-3045	Lime & Shale
3045-3486	Lime
3486	Rotary Total Depth

D & A

RECEIVED  
 STATE CORPORATION COMMISSION  
 MAY 8 - 1972  
 May 8 - 1972  
 CONSERVATION DIVISION  
 Wichita, Kansas

STATE OF KANSAS        )  
                               ) SS  
 COUNTY OF SEDGWICK    )

I, D. L. Hellar, do hereby certify that the above and foregoing is a true and correct copy of the log of the #1 Casey Jones, located in SW NW SW 7-8S-22W, Graham County, Kansas, as reflected by the files of the Hellar Drilling Company, Inc.

HELLAR DRILLING COMPANY, INC.

By *D. L. Hellar*  
 President - D. L. Hellar

Subscribed and sworn to before me, a Notary Public, in and for Sedgwick County, Kansas, this 5th day of May, 1972.

*Catherine Darcey*  
 Notary Public - Catherine Darcey

My Commission Expires: March 25, 1976.

