


Give All Information Completely
Make Required Affidavit
Mail or Deliver Report to:
Conservation Division
State Corporation Commission
211 No. Broadway
Wichita, Kansas

WELL PLUGGING RECORD

NORTH

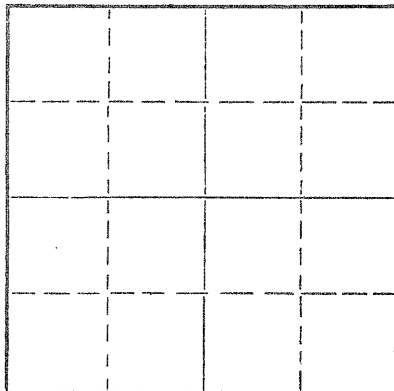

Locate well correctly on above
Section Plat

Graham County. Sec. 7 Twp. 8S Rge. 22W (E) (W)
Location as "NE/CNW*SW*" or footage from lines. C SW SE
Lease Owner Raymond Oil Company, Inc.
Lease Name Alexander Well No. 1
Office Address 110 Fourth National Bank Bldg., Wichita, Kansas
Character of Well (completed as Oil, Gas or Dry Hole) Dry Hole
Date well completed 3-11-65 19
Application for plugging filed 3-18-65 19
Application for plugging approved 3-11-65 19
Plugging commenced 3-11-65 19
Plugging completed 3-11-65 19
Reason for abandonment of well or producing formation Dry Hole

If a producing well is abandoned, date of last production _____ 19
Was permission obtained from the Conservation Division or its agents before plugging was commenced? Yes

Name of Conservation Agent who supervised plugging of this well Eldon Petty, Box 325, Hays, Kansas
Producing formation _____ Depth to top _____ Bottom _____ Total Depth of Well 3630 Feet
Show depth and thickness of all water, oil and gas formations.

OIL, GAS OR WATER RECORDS

CASING RECORD

FORMATION	CONTENT	FROM	TO	SIZE	PUT IN	PULLED OUT
Surface Hole	9"	0	218'	9"	3-9-65	

Describe in detail the manner in which the well was plugged, indicating where the mud fluid was placed and the method or methods used in introducing it into the hole. If cement or other plugs were used, state the character of same and depth placed, from _____ feet to _____ feet for each plug set.

Set Plug #1 at 540' with 20 sacks cement
Set Plug #2 at 215' with 20 sacks cement
Set Plug #3 at 20' with 10 sacks cement

RECEIVED
STATE CORPORATION COMMISSION
MAR 22 1965
MAR 22, 1965
CONSERVATION DIVISION
Wichita, Kansas

(If additional description is necessary, use BACK of this sheet)
Name of Plugging Contractor D & D Drilling Company, Inc.
Address 307 Schweiter Building, Wichita, Kansas

STATE OF Kansas, COUNTY OF Sedgwick, ss.
James R. Daniels (employee of owner) or (owner or operator) of the above-described

well, being first duly sworn on oath, says: That I have knowledge of the facts, statements, and matters herein contained and the log of the above-described well as filed and that the same are true and correct. So help me God.

(Signature) James R. Daniels
James R. Daniels
307 Schweiter Building, Wichita, Kansas
(Address)

SUBSCRIBED AND SWORN TO before me this 18th day of March, 19 65

My commission expires 11-18-66
Colleen Chapple
Colleen Chapple Notary Public.

ROTARY DRILLING LOG

OPERATOR: Raymond Oil Company, Inc. COMMENCED: 3-9-65
 CONTRACTOR: D & D Drilling Company, Inc. COMPLETED: 3-14-65
 WELL: Alexander No. 1
 LOCATION: C SW SE Section 7-8S-22W ELEVATION: 2153 RB
 COUNTY: Graham County, Kansas

Formations	Depth	Remarks
Shale & Sand	1100'	Set 218' of 9" with 185 sacks
Shale	1333'	
Sand	1554'	
Shale	1803'	
Anhydrite	1833'	
Shale	2115'	
Shale & Lime	2844'	
Shale	3055'	
Lime & Shale	3320'	
Shale & Lime	3550'	
Lime	3630'	
Rotary Total Depth	3630'	D & A

RECEIVED
 STATE CORPORATION COMMISSION

MAR 22 1965
 MAR 22, 1965
 CONSERVATION DIVISION
 Wichita, Kansas

A F F I D A V I T

State of Kansas)
) SS
 County of Sedgwick)

I, James R. Daniels, of lawful age, being duly and solemnly sworn on oath say: I am a resident of Wichita, Sedgwick County, Kansas, and I hereby know and on oath state that the above drilling log covering the Alexander No. 1, located in the C SW SE Section 7-8S-22W, Graham County, Kansas, is true and correct to the best of my knowledge and belief.

James R Daniels

 James R. Daniels

Subscribed and sworn to before me this 18th day of March, 1965.

My Commission expires:

11-18-66

Colleen Chapple

 Colleen Chapple, Notary Public