

15-065-21310-00-00

STATE OF KANSAS
STATE CORPORATION COMMISSION

FORM CP-4

WELL PLUGGING RECORD

Give All Information Completely
Make Required Affidavit
Mail or Deliver Report to
Conservation Division
State Corporation Comm.
245 North Water
Wichita, KS 67202

Graham County Sec. 8 Twp. 8S Rge. 22 W/W
Location as "NE/CNW/SW" or footage from lines _____
C N/2-SE-SE

Lease Owner Hi-Kat Petroleum

Lease Name Roger Jones Well No. 1

Office Address P.O. Box 1261 Liberal Kansas 67901

Character of Well (Completed as Oil, Gas or Dry Hole) _____

Dry Hole

Date Well completed November 18, 1980 19 80

Application for plugging filed November 18, 19 80

Application for plugging approved November 18, 19 80

Plugging commenced November 18, 11:00 A.M. 19 80

Plugging completed November 18, 12:45 P.M. 19 80

Reason for abandonment of well or producing formation _____
No Commercial Production

If a producing well is abandoned, date of last production _____
19 _____


Was permission obtained from the Conservation Division or its agents before plugging was commenced? yes

Name of Conservation Agent who supervised plugging of this well Gil Balthazor

Producing formation _____ Depth to top _____ Bottom _____ Tl. Depth of Well 3514'

Show depth and thickness of all water, oil and gas formations.

locate well correctly
on above
Section Plot

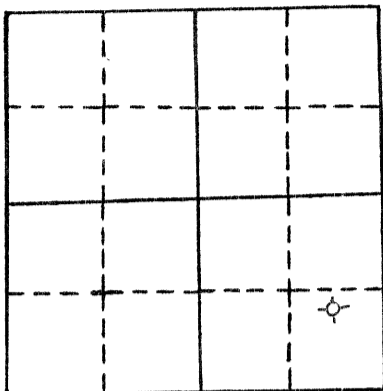

OIL, GAS OR WATER RECORDS

CASING RECORD

FORMATION	CONTENT	FROM	TO	SIZE	PUT IN	PULLED OUT
surface casing	common	0	204.64'	8 5/8"	204.64'	0

Describe in detail the manner in which the well was plugged, indicating where the mud fluid was placed and the method or methods used in introducing it into the hold. If cement or other plugs were used, state the character of same and depth placed, from _____ feet to _____ feet for each plug set.

Plug #1 @ 700' with 70 sxs

Plug #2 @ 200' with 20 sxs

Plug #3 @ 40' with 10 sxs

5 sxs in rathole

plugdown @ 12:45 P.M.

DEC 11 1980
CONSERVATION DIVISION
Kansas

(If additional description is necessary, use BACK of this sheet)

Name of Plugging Contractor Pioneer Drilling Company, Inc.

308 West Mill Plainville, Kansas 67663

STATE OF Kansas COUNTY OF Seward, ss.


George R. Balloun

(~~Signature of owner or operator~~) (owner or operator) of the

above described well, being first duly sworn on oath, says: That I have knowledge of the facts, statements, and matters herein contained and the log of the above described well is filed and that the same are true and correct. So help me God.

(Signature) Geo R. Balloun

(Address) Box 1261 Liberal Ks 67901

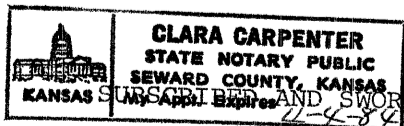

TO before me this 9th day of December, 1980

My commission expires April 4, 1984

Clara Carpenter
Notary Public

WELL LOG

OPERATOR: Hi-Kat Petroleum

WELL NAME: Roger Jones #1 LOCATION: CnN 1/2-SE-SE 8-8S-22W

COUNTY: Graham STATE: Kansas

WELL COMMENCED: November 10, 1980 WELL COMPLETED: November 20, 1980

ELEVATION: 2087 K.B. TOTAL DEPTH: 3514'

PRODUCTION: D&A RIG NO: 3

CASING - 8 5/8": 204.64 used 28# cemented with 150 sxs common 2%gel 3% cc did circ

5 1/2": none

ALL MEASUREMENTS TAKEN FROM THE TOP OF ROTARY BUSHING:

FROM	TO	FORMATION	DEVIATION FROM VERTICAL	REMARKS:
0'	213'	sand and shale	213' -1-degree	
213'	315'	cement and shale and sand		
315'	1575'	shale and sand		
1575'	1712'	shale and sand		
1712'	1744'	shale and sand	1773' -0-degree	
1744'	1785'	anhydrite		
1785'	2060'	shale and sand		
2060'	2316'	shale		
2316'	2528'	shale		
2528'	2730'	shale and lime		
2730'	2940'	lime and shale		
2940'	2984'	lime and shale		
2984'	3038'	lime and shale		
3038'	3058'	lime and shale		
3058'	3175'	lime and shale		
3175'	3187'	lime and shale		
3187'	3223'	lime and shale		
3223'	3331'	lime and shale		
3331'	3350'	lime and shale		
3350'	3378'	lime and shale	3378' -1/4-degree	
3378'	3383'	lime and shale		
3383'	3462'	lime and shale		
3462'	3497'	lime and shale		
3497'	3514'	lime and shale		
3514'	TD			

DEC 11, 1980
DEC 11 1980

CONSERVATION DIVISION
Wichita, Kansas

STATE OF KANSAS
COUNTY OF

The undersigned hereby certifies that to the best of his knowledge and belief, the above facts are true and correct

PIONEER DRILLING CO., INC.

By Cornie J. Austin

SUBSCRIBED AND SWORN TO, BEFORE ME, This 25th day of November, 19 80

Sharon Garvert
NOTARY PUBLIC

Sharon Garvert

