

STATE OF KANSAS
STATE CORPORATION COMMISSION


WELL PLUGGING RECORD

Give All Information Completely
Make Required Affidavit
Mail or Deliver Report to:
Conservation Division
State Corporation Commission
800 Bitting Building
Wichita, Kansas

GRAHAM County. Sec. 9 Twp. 8 Rge. 22 (E) W (W)

Location as "NE/CNW&SW" or footage from lines NW SW SW
Lease Owner EMPIRE DRILLING COMPANY & D. L. SOMERS
Lease Name KNOUF Well No. 1
Office Address 407 BROWN BUILDING, WICHITA 2, KANSAS
Character of Well (completed as Oil, Gas or Dry Hole) DRY HOLE
Date well completed 4-26 1955
Application for plugging filed 4-26 1955
Application for plugging approved 4-26 1955
Plugging commenced 4-26 1955
Plugging completed 4-26 1955
Reason for abandonment of well or producing formation DRY HOLE

NORTH

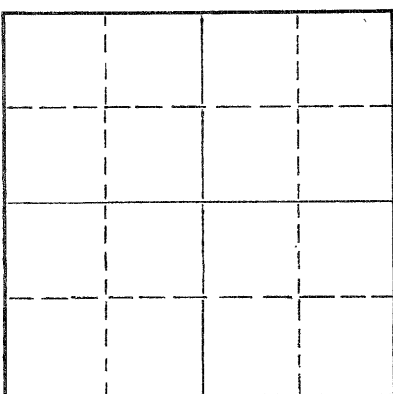

Locate well correctly on above Section Plat

If a producing well is abandoned, date of last production 19
Was permission obtained from the Conservation Division or its agents before plugging was commenced? YES

Name of Conservation Agent who supervised plugging of this well ELDON PETTY
Producing formation _____ Depth to top _____ Bottom _____ Total Depth of Well 3525 Feet
Show depth and thickness of all water, oil and gas formations.

OIL, GAS OR WATER RECORDS

CASING RECORD

FORMATION	CONTENT	FROM	TO	SIZE	PUT IN	PULLED OUT
SURFACE		0	179'	8 5/8"	179'	0

Describe in detail the manner in which the well was plugged, indicating where the mud fluid was placed and the method or methods used in introducing it into the hole. If cement or other plugs were used, state the character of same and depth placed, from _____ feet to _____ feet for each plug set.

FIRST PLUG @ 175' - 1/2 SACK HULLS AND 15 SACKS OF CEMENT
TOP PLUG @ 40' - 10 SACKS OF CEMENT

MAY 4 1955

(If additional description is necessary, use BACK of this sheet)
Name of Plugging Contractor EMPIRE DRILLING COMPANY
Address 407 BROWN BUILDING, WICHITA 2, KANSAS

STATE OF KANSAS, COUNTY OF SEDGWICK, ss.
I, DAN J. KORNFELD (employee of owner) or (owner) or operator of the above-described well, being first duly sworn on oath, says: That I have knowledge of the facts, statements, and matters herein contained and the log of the above-described well as filed and that the same are true and correct. So help me God.

(Signature) DAN J. KORNFELD
407 BROWN BUILDING, WICHITA 2, KANSAS
(Address)

SUBSCRIBED AND SWORN TO before me this 3RD day of MAY, 1955

[Signature of Notary Public]

My commission expires DECEMBER 10, 1956

Notary Public.

PLUGGING
FILE SEC 9 T 8 R 22W
BOOK PAGE 115 LINE 34

LOG

COMPANY: D. L. SOMERS & EMPIRE
DRILLING COMPANY

CONTRACTOR: EMPIRE DRILLING COMPANY

FARM: #1 KNOUF

LOCATION: NW SW SW, SEC. 9-8-22
GRAHAM COUNTY, KANSAS

COMMENCED: 4-19-55

COMPLETED: 4-26-55

0	TO	195	SURFACE
195	TO	1710	SHALE AND SAND
1710	TO	1741	ANHYDRITE
1741	TO	2260	SHALE AND SHELLS
2260	TO	2840	LIME AND SHALE
2840	TO	3180	SHALE AND SHELLS
3180	TO	3240	SHALE AND LIME
3240	TO	3320	LIME AND SHALE STREAKS
3320	TO	3395	LIME
3395	TO	3475	LIME AND SHALE STREAKS
3475	TO	3525	LIME
3525			R.T.D.

SET 179' OF 8 5/8" SURFACE CASING, CEMENTED WITH 115 SACKS OF CEMENT.

ELEVATION: 2086 K.B.

TOPS: ANHYDRITE 1710'; HEEBNER 3296'; TORONTO 3317'; LANSING 3331'; R.T.D. 3525.

D.S.T. #1 3499' TO 3525'; D.S.T. #2 MIS-RUN; D.S.T. #3 3502' TO 3570'.

D & A

May 4th 1955 *Received!*

C E R T I F I C A T I O N

I, DAN J. KORNFELD, DO HEREBY CERTIFY THAT THE ABOVE AND FOREGOING IS A TRUE AND CORRECT COPY OF THE LOG ON THE #1 KNOUF, NW SW SW, SECTION 9, 8 SOUTH, 22 WEST, GRAHAM COUNTY, KANSAS, AS REFLECTED BY THE FILES OF THE EMPIRE DRILLING COMPANY.

Dan J. Kornfeld
DAN J. KORNFELD

SUBSCRIBED AND SWORN TO BEFORE ME A NOTARY PUBLIC WITHIN AND FOR SEDGWICK COUNTY, KANSAS THIS 2ND DAY OF MAY, 1955.

MY COMMISSION EXPIRES DECEMBER 10, 1956.

[Signature]
NOTARY PUBLIC

