


15-065-00179-00-00

STATE OF KANSAS
STATE CORPORATION COMMISSION

Give All Information Completely
Make Required Affidavit
Mail or Deliver Report to:
Conservation Division
State Corporation Commission
800 Bitting Building
Wichita, Kansas

WELL PLUGGING RECORD

Graham County. Sec. 12 Twp. 9 Rge. 22 (E) W (W)
Location as "NE/CNW $\frac{1}{4}$ SW $\frac{1}{4}$ " or footage from lines SW NW SW
Lease Owner Nadel and Gussman
Lease Name Dixon Well No. 1
Office Address Box 309 Tulsa, Oklahoma
Character of Well (completed as Oil, Gas or Dry Hole) Dry
Date well completed 12-4-50
Application for plugging filed 12-4-50
Application for plugging approved 12-4-50
Plugging commenced 12-4-50
Plugging completed 12-4-50
Reason for abandonment of well or producing formation Dry

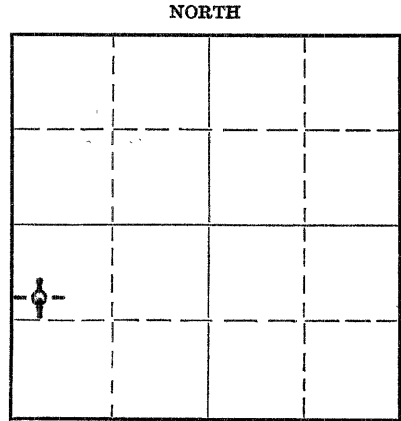

Locate well correctly on above Section Flat

If a producing well is abandoned, date of last production 19
Was permission obtained from the Conservation Division or its agents before plugging was commenced?

Name of Conservation Agent who supervised plugging of this well Eldon Petty
Producing formation Depth to top Bottom Total Depth of Well 3653 Feet
Show depth and thickness of all water, oil and gas formations.

OIL, GAS OR WATER RECORDS

CASING RECORD

Formation	Content	From	To	Size	Put In	Pulled Out
				13-3/8"	80'	None

Describe in detail the manner in which the well was plugged, indicating where the mud fluid was placed and the method or methods used in introducing it into the hole. If cement or other plugs were used, state the character of same and depth placed, from feet to feet for each plug set.

Filled hole with heavy mud from total depth to 200' -
set bridge and cemented with 25 sacks cement. Set plug
at top with 15 sacks cement.

(If additional description is necessary, use BACK of this sheet)

Correspondence regarding this well should be addressed to Nadel and Gussman
Address P. O. Box 309
Tulsa, Oklahoma

STATE OF KANSAS, COUNTY OF SEDGWICK, ss.
L. C. Hay (employee of owner) or (~~owner or operator~~) of the above-described well,
being first duly sworn on oath, says: That I have knowledge of the facts, statements, and matters herein contained and the log of the above-described well as filed and that the same are true and correct. So help me God.


(Signature) L. C. Hay
703 Union National Bank Building, Wichita
(Address)

SUBSCRIBED AND SWORN to before me this 8th day of December, 1950

My commission expires Nov. 3, 1952

STATE OF KANSAS
[Signature] Notary Public.

28-8273-s 4-50-10M

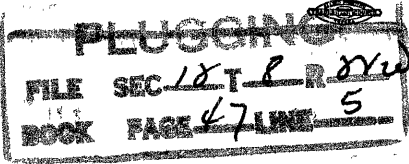

DEC 13 1950
CONSERVATION DIVISION
Wichita, Kansas

12-13-50

WELL LOG

NADEL AND GUSSMAN

DIXON No. 1

330' E and 990' S of
NWc SW/4 12-8-22W
Graham County, Kansas

Comm: 11-22-50
Comp: 12- 3-50

Casing: 13-3/8' Csg Cx w/100 sax

Formations	Depths
Sand and Clay	40
Slate, sand and rock	84
Shale-sand	330
Shale	800
Sand and shale	1070
Shale and red bed	1635
Anhydrite	1670
Shale and shells	2370
Broken Lime	2405
Lime-shale	2515
Shale-shells	2685
Lime-shale	3185
Lime	3257
Shale	3265
Lime	3500
Shale and lime	3543
Conglomerate	3628
Arbuckle	3653 T.D.

Geological Tops

Heebner	3238
Toronto	3258
Lansing	3276
B. Kansas City	3492?
Conglomerate	3548
Arbuckle	3628

STATE OF KANSAS }
COUNTY OF SEDGWICK } SS

L. C. Hay, of lawful age, deposes and states that the above formations and depths are true and correct as taken from the daily drilling log on the Dixon No. 1 Well in the NW SW 12-8-22W, Graham County, Kansas.

L. C. Hay
Nola Brooks
Notary Public

Subscribed and sworn to before me this 7th day of December, 1950.

My commission expires Nov 3 1952
PLUGGING
FILE SEC 12 8 NW
BOOK 47 LINE 5

DIVISION
12-13-50