

STATE OF KANSAS
 STATE CORPORATION COMMISSION
 200 Colorado Derby Bldg.
 Wichita, Kansas 67202


Form CP-4
 Rev. 12-15-80

WELL PLUGGING RECORD

15-065-21754-00-00

Give All Information Completely
 Make Required Affidavit

COUNTY Graham SEC. 13 TWP. 8 RGE. 22 E/W
 Location as in quarters or footage from lines:
NE NE SW

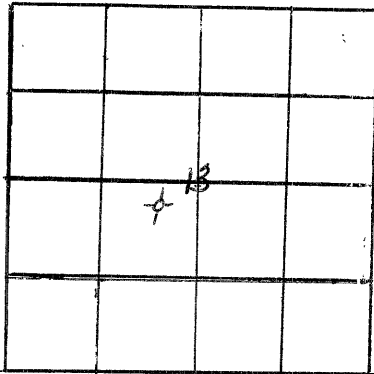

Locate Well
 correctly on above
 Section Platt.

Lease Owner Galloway Drilling Co., Inc.
 Lease Name RADCLIFFE Well No. 1
 Office Address 340 Broadway Plaza Bldg.
105 So. Broadway, Wichita, KS 67202
 Character of Well (Completed as Oil, Gas or Dry Hole):
 Date Well Completed 1/24/83
 Application for plugging filed Yes
 Plugging commenced 1/24/83
 Plugging completed 1/24/83
 Reason for abandonment of well or producing formation dry hole

Was permission obtained from the Conservation Division or it's
 Agent's before plugging was commenced? yes

Name of Conservation Agent who supervised plugging of this well Marion Schmidt
 Producing formation none Depth to top bottom T.D. 3677'

Show depth and thickness of all water, oil and gas formations.

OIL, GAS OR WATER RECORDS

Casing Record

Formation	Content	From	To	Size	Put in	Pulled Out
				8 5/8	259'	None

Describe in detail the manner in which the well was plugged, indicating where the mud
 fluid was placed and the method or methods used in introducing it into the hold. If cement
 or other plugs were used, state the character of same and depth placed, from feet
 to feet for each plug set.

1st Plug 3677 - 20 sx
 2nd Plug 1690 - 20 sx
 3rd Plug 900 - 100 sx
 4th Plug 270 - 40 sx
 5th Plug 40 - 10 sx
 Rat Hole 10 sx

Common cement 50-50 Pox + 6% Gel, Plug Down 3:45 p.m. 1/23/83

(If additional description is necessary, use BACK of this sheet)

Name of Plugging Contractor Allied Cementing, Russell, KS

STATE OF KANSAS COUNTY OF SEDGWICK, ss.

Jay H. Galloway (~~employee of owner~~) or (owner or operator) of the
 above-described well, being first duly sworn on oath, says: That I have knowledge of the
 facts, statements, and matters herein contained and the log of the above-described well as
 filed and that the same are true and correct. So help me God.

(Signature) J H Galloway
Jay H. Galloway, President
 (Address)

SUBSCRIBED AND SWORN, TO before me this 4th day of February, 19 83

EARLENE M. LUMRY
 STATE NOTARY PUBLIC
 SEDGWICK COUNTY, KANSAS
 MY APPT. EXP.

My Commission Expires Sept. 7, 1985

Earlene M. Lumry
 STATE Notary Public

FEB 8 1983
 2-8-83
 CONSERVATION DIVISION
 Wichita Kansas