


15-069-00826-00-00

STATE OF KANSAS
STATE CORPORATION COMMISSION

Give All Information Completely
Make Required Affidavit
Mail or Deliver Report to:
Conservation Division
State Corporation Commission
211 No. Broadway
Wichita, Kansas

WELL PLUGGING RECORD

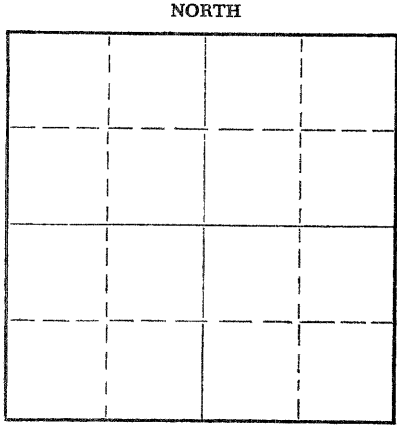

Locate well correctly on above
Section Plat

Graham

County. Sec. 1 Twp. 8S Rge. 23W (E) (W)

Location as "NE/CNW/SW" or footage from lines C NE SW

Lease Owner Burch Drilling Co., Inc.

Lease Name Ellsworth Well No. 1

Office Address 1011 Union Center, Wichita, Kansas

Character of Well (completed as Oil, Gas or Dry Hole) Dry Hole

Date well completed 3-27-59 19

Application for plugging filed 3-27-59 19

Application for plugging approved 3-27-59 19

Plugging commenced 3-27-59 19

Plugging completed 3-27-59 19

Reason for abandonment of well or producing formation Dry Hole

If a producing well is abandoned, date of last production 19

Was permission obtained from the Conservation Division or its agents before plugging was commenced? yes

Name of Conservation Agent who supervised plugging of this well A. D. Fabricus

Producing formation Depth to top Bottom Total Depth of Well 3675 Feet

Show depth and thickness of all water, oil and gas formations.

OIL, GAS OR WATER RECORDS

CASING RECORD

FORMATION	CONTENT	FROM	TO	SIZE	PUT IN	PULLED OUT

Describe in detail the manner in which the well was plugged, indicating where the mud fluid was placed and the method or methods used in introducing it into the hole. If cement or other plugs were used, state the character of same and depth placed, from feet to feet for each plug set.

1st plug set at 600' with 20 sacks cement
2nd plug set at 215' with 20 sacks cement
3rd plug set at 40' with 10 sacks cement

RECEIVED
STATE CORPORATION COMMISSION
APR 2 1959
CONSERVATION DIVISION
Wichita, Kansas

4-2-59

(If additional description is necessary, use BACK of this sheet)
Name of Plugging Contractor Burch Drilling Co., Inc.
Address 1011 Union Center, Wichita, Kansas

STATE OF KANSAS, COUNTY OF SEDGWICK, ss.

Earl M. Burch, President (employee or owner)

well, being first duly sworn on oath, says: That I have knowledge of the facts, statements, and matters herein contained and the log of the above-described well as filed and that the same are true and correct. So help me God.

(Signature) Earl M Burch

1011 Union Center, Wichita, Ks.
(Address)

SUBSCRIBED AND SWORN TO before me this 1st day of April, 1959.

My commission expires July 27, 1960.

Notary Public.

PLUGGING
FILE SEC. 1 T 8 R 23W
BOOK PAGE 27 LINE 15

15-069-00826-00-00

WELL LOG

Burch Drilling Co., Inc.
1 Ellsworth
C NE SW 1-8S-23W
Graham County, Kansas

8 5/8" set @ 215' w/165 sx.
Commenced: 3-19-59
Completed: 3-27-59
Elevation: 2198 Kelly Bushing
D & A

RECEIVED
STATE CORPORATION COMMISSION

APR 2 1959

CONSERVATION DIVISION
Wichita, Kansas

- 1820 Shale & Shells
- 1845 Shale
- 1878 Anhydrite
- 1985 Shale & Lime streaks
- 2517 Shale
- 3336 Lime & Shale
- 3387 Lime
- 3535 Lime & Shale
- 3675 Lime
- 3675 Rotary Total Depth

	<u>Tops</u>
Heebner	3422
Toronto	3446
Lansing-KC	3465
Base Kansas City	3667
RTD	3675

DST # 1 3522-3535 Open 1 hr.
Rec. 38' oil cut mud. IBHP
(30 min) 1180#, IFP 0#, FFP 0#,
FBHP (30 min) 1020#.

DST # 2 3614-3640 Open 30 min.
Rec. 8' mud. IFP 0#, FFP 0#,
IBHP 0 #, FBHP 0#.

STATE OF KANSAS, COUNTY OF SEDGWICK

I, Earl M. Burch, President of Burch Drilling Co., Inc. being duly sworn on oath, state: That I have knowledte of the facts, statements and matters herein contained and that the same are true and correct.

Earl M Burch

Subscribed and sworn to before me this 1st day of April, 1959.

Notary Public

My commission expires: July 27, 1960.

PLUGGING
FILE SEC. 1 T. 8 R. 23W
BOOK PAGE 27 LINE 15