

STATE OF KANSAS  
STATE CORPORATION COMMISSION


Give All Information Completely  
Make Required Affidavit  
Mail or Deliver Report to:  
Conservation Division  
State Corporation Commission  
800 Bitting Building  
Wichita, Kansas

WELL PLUGGING RECORD

Graham County. Sec. 2 Twp. 8 Rge.      (E) 23(W)

Location as "NE/CNW%SW%" or footage from lines SE SE SW  
Lease Owner Harry Gore  
Lease Name Griffith Well No. 2  
Office Address 400 Brown Building, Wichita, Kansas  
Character of Well (completed as Oil, Gas or Dry Hole) dry hole  
Date well completed 9-1-55 19  
Application for plugging filed 9-14-55 19  
Application for plugging approved 9-15-55 19  
Plugging commenced 9-15-55 19  
Plugging completed 9-18-55 19  
Reason for abandonment of well or producing formation dry

NORTH

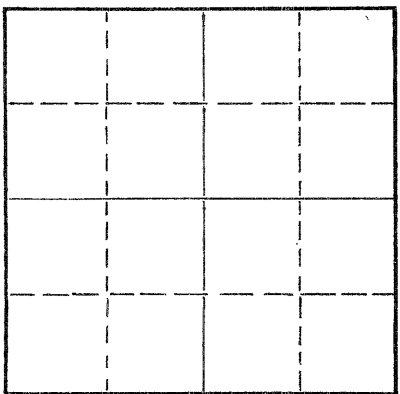

Locate well correctly on above Section Plat

If a producing well is abandoned, date of last production      19  
Was permission obtained from the Conservation Division or its agents before plugging was commenced? yes

Name of Conservation Agent who supervised plugging of this well Eldon Petty  
Producing formation      Depth to top      Bottom      Total Depth of Well 3927 Feet  
Show depth and thickness of all water, oil and gas formations.

OIL, GAS OR WATER RECORDS

CASING RECORD

FORMATION	CONTENT	FROM	TO	SIZE	PUT IN	PULLED OUT
				8-5/8	226	none
				5-1/2	3650	3022

Describe in detail the manner in which the well was plugged, indicating where the mud fluid was placed and the method or methods used in introducing it into the hole. If cement or other plugs were used, state the character of same and depth placed, from      feet to      feet for each plug set.

<u>3616 to 3570 ft.</u>	<u>Filled with sand.</u>
<u>3570 to 3540 ft.</u>	<u>5 sks. cement.</u>
<u>3540 to 225 ft.</u>	<u>Mudded.</u>
<u>225 to 215 ft.</u>	<u>Rock bridge.</u>
<u>215 to 170 ft.</u>	<u>15 sks. cement</u>
<u>170 to 30 ft.</u>	<u>Mud.</u>
<u>30 ft. to cellar</u>	<u>10 sks. cement.</u>

(If additional description is necessary, use BACK of this sheet)

Name of Plugging Contractor R & S Pipe Pulling Co.  
Address Box 192, Ellinwood, Kansas

STATE OF Kansas, COUNTY OF Sedgwick, ss.  
Theodore Gore (employer or owner) or (owner or operator) of the above-described well, being first duly sworn on oath, says: That I have knowledge of the facts, statements, and matters herein contained and the log of the above-described well as filed and that the same are true and correct. So help me God

(Signature) Theodore Gore  
400 Brown Bldg., Wichita, Kansas  
(Address)

SUBSCRIBED AND SWORN TO before me this 27th day of September, 19 55


Charlotte Klitchka  
Notary Public.

My commission expires June 7, 1956

**PLUGGING**  
FILE SEC. 2 T. 8 R. 23W  
BOOK PAGE 149 LINE 42

VED  
COMMISSION  
1955  
Sep 28

Veeder Supply & Dev'l. Co.

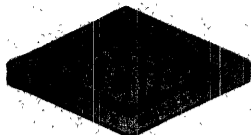

Cherryvale, Kansas

Drilled for Harry Gore-Veeder Supply & Dev'l. Co. Farm Griffith No. 2 Depth 3927  
 Contractor Veeder Supply & Dev'l. Co. Pipe 3650' 5 1/2" casing, cemented w/ 100 sacks cen  
 Location SE/4 SE/4 SW/4 Sec. 2 Twp. 8 Range 23  
 Commenced 8-22-1955 Completed 9-1-1955 County Graham State Kansas

Cellar	0	9	9	TOPS: <u>KB 2239</u>	
Yellow clay	9	25	16		
Sand, shale	25	70	45	Heebner	3467
Shale	70	226	156	Toronto	3492
Grah shale	226	400	174	Lansing	3510
Shale, shells	400	845	445	Base KC	3714
Shale, shells, sand	845	1460	615	Shaley Cong.	3872
Sand and shale	1460	1640	180	Weathered Arbuckle	3880
Shale, shells, red bed	1640	1700	60		
Shale	1700	1887	187		
Anhydrite	1887	1921	34		
Shale and lime	1921	2000	79		
Shale and shells	2000	2150	150		
Shale, lime streaks	2150	2220	70		
Shale and lime	2220	2878	758		
Lime	2878	3065	187		
Lime and shale	3065	3535	470		
Cherty lime	3535	3547	12		
Lime	3547	3927	380		
Total Depth	3927				

AFFIDAVIT

STATE OF KANSAS )  
 Montgomery County) SS

Leo C. Veeder, of lawful age, being first duly sworn on oath, deposes and says:

THAT he is a resident of Cherryvale, Kansas; that he knows and on oath hereby states that the above drilling log covering the Griffith #2 well located in Section 2-8-23, Graham County, Kansas, is true and correct. Further affiant saith not.

THE VEEDER SUPPLY AND DEVELOPMENT CO.

BY Leo C. Veeder.  
 Leo C. Veeder.

Subscribed and sworn to before me this 6th day of September, 1955.

Leo Samsow  
 Notary Public

My commission expires July 11, 1956.

D+A

**PLUGGING**  
 FILE SEC 2 T 8 R 23W  
 BOOK PAGE 149 LINE 49

RECEIVED  
 STATE COMMISSIONER OF GEOL. & MINES  
 SEP 15 1955  
 DIVISION  
 Wichita, Kansas