


15-065-02633-00-00

WELL PLUGGING RECORD

Give All Information Completely  
Make Required Affidavit  
Mail or Deliver Report to:  
Conservation Division  
State Corporation Commission  
212 North Market, Insurance Bldg.  
Wichita, Kansas

NORTH

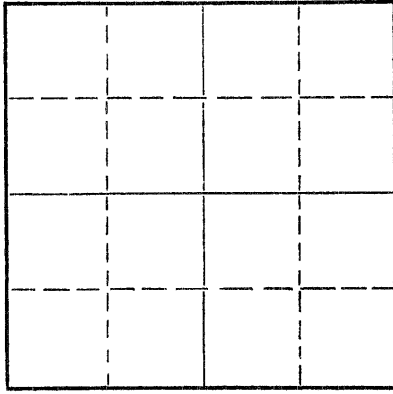

Locate well correctly on above  
Section Plat

Graham County, Sec. 3 Twp. 8S Rge. (E) 23 (W)

Location as "NE/CNW%SW%" or footage from lines SE SW

Lease Owner JOHN O. FARMER, INC.

Lease Name JONES "C" Well No. 1

Office Address Russell, Kansas

Character of Well (completed as Oil, Gas or Dry Hole) Dry

Date well completed 7/1 19 60

Application for plugging filed 7/1 19 60

Application for plugging approved 7/1 19 60

Plugging commenced 7/1 19 60

Plugging completed 7/1 19 60

Reason for abandonment of well or producing formation Dry

If a producing well is abandoned, date of last production 19

Was permission obtained from the Conservation Division or its agents before plugging was commenced? yes

Name of Conservation Agent who supervised plugging of this well Fabricius

Producing formation Depth to top Bottom Total Depth of Well 3800 Feet

Show depth and thickness of all water, oil and gas formations.

OIL, GAS OR WATER RECORDS

CASING RECORD

FORMATION	CONTENT	FROM	TO	SIZE	PUT IN	PULLED OUT
				8-5/8"	165'	None

Describe in detail the manner in which the well was plugged, indicating where the mud fluid was placed and the method or methods used in introducing it into the hole. If cement or other plugs were used, state the character of same and depth placed, from feet to feet for each plug set.

First plug set at 540 feet with 20 sacks cement

Second plug set at 160 feet with 20 sacks cement

Third plug set at 40 feet with 10 sacks cement

RECEIVED  
STATE CORPORATION COMMISSION

JUL 13 1960

CONSERVATION DIVISION  
Kansas

7-13-60

(If additional description is necessary, use BACK of this sheet)

Name of Plugging Contractor JOHN O. FARMER, INC.

Address Russell, Kansas

STATE OF Kansas COUNTY OF Russell, ss.  
I, JOHN O. FARMER (employee of owner) or (owner or operator) of the above-described

well, being first duly sworn on oath, says: That I have knowledge of the facts, statements, and matters herein contained and the log of the above-described well as filed and that the same are true and correct. So help me God

(Signature) John O. Farmer

Russell, Kansas

(Address)

SUBSCRIBED AND SWORN TO before me this 12th day of July, 19 60

My commission expires October 11, 1962

Lucille Kennedy Notary Public.


OPERATOR JOHN O. FARMER, INC.

ADDRESS Russell, Kansas

FORMATION RECORD

Give detailed description and thickness of all formation drilled through, contents of sand, whether dry, water, oil or gas.

23W RGE. 88 TWP. 3 SEC. 1 COUNTY GRAHAM WELLS "C" FARM NAME JONES

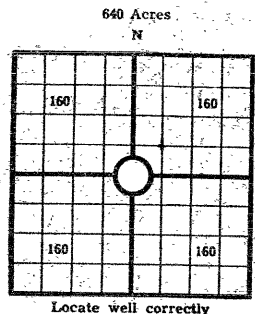

COUNTY Graham, SEC. 3, TWP. 88, RGE. 23W  
 COMPANY OPERATING JOHN O. FARMER, INC.  
 OFFICE ADDRESS Russell, Kansas  
 DRILLING STARTED 6/23 1960 DRILLING FINISHED 7/1, 1960  
 DATE OF FIRST PRODUCTION \_\_\_\_\_ COMPLETED \_\_\_\_\_  
 WELL LOCATED SE  $\frac{1}{4}$  SW  $\frac{1}{4}$  \_\_\_\_\_, North of South  
 Line and \_\_\_\_\_ ft. East of West Line of Quarter Section  
 Elevation (Relative to sea level) DERRICK FLOOR 2291 GROUND, 2291  
 CHARACTER OF WELL (Oil, gas or dryhole) Dry

OIL OR GAS SANDS OR ZONES

Name	From	To	Name	From	To
1			4		
2			5		
3			6		

Perforating Record If Any

Shot Record

Formation	From	To	No. of Shots	Formation	From	To	Size of Shot

CASING RECORD

Amount Set					Amount Pulled				Packer Record		
Size	Wt.	Thds.	Make	Ft.	In.	Ft.	In.	Size	Length	Depth Set	Make
8-5/8				165							

Liner Record: Amount \_\_\_\_\_ Kind \_\_\_\_\_ Top \_\_\_\_\_ Bottom \_\_\_\_\_

CEMENTING AND MUDDING

Size	Amount Set		Sacks Cement	Chemical		Method of Cementing	Amount	Mudding Method	Results (See Note)
	Ft.	In.		Gal.	Make				
8-5/8	165		120						

Note: What method was used to protect sands if outer strings were pulled?

NOTE: Were bottom hole plugs used? \_\_\_\_\_ If so, state kind, depth set and results obtained \_\_\_\_\_

TOOLS USED

Rotary Tools were used from \_\_\_\_\_ feet to \_\_\_\_\_ Cable tools were used from \_\_\_\_\_ feet to \_\_\_\_\_ feet, and from \_\_\_\_\_ feet to \_\_\_\_\_ feet, and from \_\_\_\_\_ feet to \_\_\_\_\_

Type Rig \_\_\_\_\_

INITIAL PRODUCTION TEST

Describe initial test: whether by flow through tubing or casing or by pumping \_\_\_\_\_

Amount of Oil Production \_\_\_\_\_ bbls. Size of choke, if any \_\_\_\_\_ Length of test \_\_\_\_\_ Water

Production \_\_\_\_\_ bbls. Gravity of oil \_\_\_\_\_ Type of Pump if pump is used, describe \_\_\_\_\_

Formation	Top	Bottom	Formation	Top	Bottom
Surface	0	160			
Shale	160	720			
Shale & sand	720	1440	FARM NAME:		
Shale	1440	1870	JONES C" #1		
Shale & shells	1870	1958			
Anhydrite	1958	1995			
Shale & shells	1995	2330			
Lime & shale	2330	2520	ELEVATION:	RB	2296
Shale & lime	2520	2800	SAMPLE TOPS:		
Lime & shale	2800	3645	Anhydrite		1958
Lime	3645	3800	Heebner		3536
T.D.		3800	Toronto		3564
			Lansing		3580
			B/KC		3788
			T.D.		3800
			D & A		

RECEIVED  
 CONSERVATION COMMISSION  
 JUL 13 1960  
 CONSERVATION DIVISION  
 Wichita, Kansas  
 7-13-60

15-065-02633-00-00

I, the undersigned, being first duly sworn upon oath, state that this well record is true, correct and complete according to the records of this office and to the best of my knowledge and belief.

*John O. Farmer*  
 Name and title of representative of company  
 President

Subscribed and sworn to before me this 12th day of July, 1960  
 My Commission expires 10/11/62

*Smiles Kennedy*  
 Notary Public