

15-065-20776-00-00


STATE OF KANSAS
STATE CORPORATION COMMISSION

Form CP-4

WELL PLUGGING RECORD

Give All Information Completely
Make Required Affidavit
Mail or Deliver Report to:
Conservation Division
State Corporation Commission
212 No. Market
Wichita, Kansas 67202

NORTH

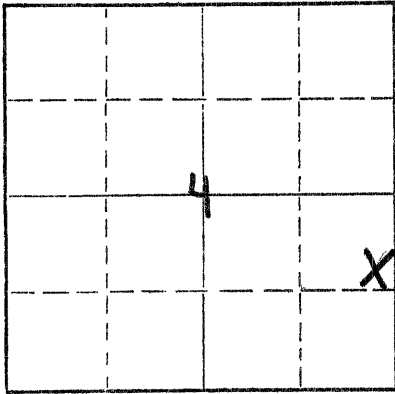

Locate well correctly on above
Section Plat

Graham County, Sec. 4 Twp. 8S Rge. 23 (W)
Location as "NE/CNW%SW%" or footage from lines A/C SE NE SE
Lease Owner Petroleum, Inc.
Lease Name JOHNSON 'A-B' Well No. #1
Office Address R. R. #2 Great Bend, Kansas 67530
Character of Well (completed as Oil, Gas or Dry Hole) Dry Hole
Date well completed September 12, 1975
Application for plugging filed September 12, 1975
Application for plugging approved September 12, 1975
Plugging commenced September 12, 1975
Plugging completed September 12, 1975
Reason for abandonment of well or producing formation No commercial quantity of oil or gas encountered.
If a producing well is abandoned, date of last production 19
Was permission obtained from the Conservation Division or its agents before plugging was commenced? Yes

Name of Conservation Agent who supervised plugging of this well Gilbert Balthazor
Producing formation _____ Depth to top _____ Bottom _____ Total Depth of Well 3810 Feet
Show depth and thickness of all water, oil and gas formations.

OIL, GAS OR WATER RECORDS

CASING RECORD

FORMATION	CONTENT	FROM	TO	SIZE	PUT IN	PULLED OUT
				8 5/8"	207.28'	None

Describe in detail the manner in which the well was plugged, indicating where the mud fluid was placed and the method or methods used in introducing it into the hole. If cement or other plugs were used, state the character of same and depth placed, from _____ feet to _____ feet for each plug set.


1st Plug Set @ 950' with 70 sx. cement
2nd Plug Set @ 200' with 40 sx. cement
3rd Plug Set @ 40' with 10 sx. cement
Plug was down @ 2:00 p.m. September 12, 1975

Name of Plugging Contractor Abercrombie Drilling, Inc. 9-17-75
Address 801 Union Center, Wichita, Kansas 67202

STATE OF KANSAS COUNTY OF SEDGWICK, ss.
Jerry A. Langrehr - Exec. V.P. (employee of owner) or (owner or operator) of the above-described well, being first duly sworn on oath, says: That I have knowledge of the facts, statements, and matters herein contained and the log of the above-described well as filed and that the same are true and correct. So help me God.

(Signature) Jerry A. Langrehr
801 Union Center, Wichita, Kansas 67202
(Address)

Subscribed and sworn to before me this 16th day of September, 1975

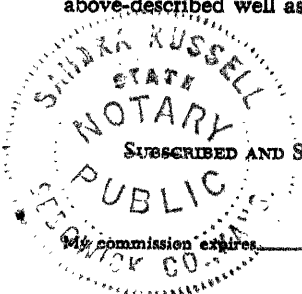

July 21, 1979

Sandra Russell
Sandra Russell
Notary Public.

CONTRACTOR'S WELL LOG

13-065-20776-00-00

OPERATOR:
CONTRACTOR:
WELL NAME:
LOCATION:
SPUD DATE:
COMPLETION DATE:

Petroleum, Inc.
Abercrombie Drilling, Inc.
JOHNSON 'A-B' #1
A/C SE NE SE Sec. 4-8S-23W
Graham County, Kansas
September 6, 1975
September 12, 1975

0	140	Surface dirt
140	210	Shale
210	381	Sand & Shale
381	1961	Shale & Sand
1961	1994	Anhydrite
1994	2645	Shale
2645	2920	Lime & Shale
2920	3240	Shale & Lime
3240	3670	Lime & Shale
3670	3810	Lime
	3810	Rotary Total Depth

Spudded in @ 10:15 a.m. September 6, 1975. Drilled 210' of 12 1/4" hole. Ran 5 jts. new 8 5/8" surface casing. Set @ 207.28'. Cemented with 150 sacks Sunset Cement. Cement circulated. Plug was down @ 2:00 p.m. September 6, 1975.
Plugged and Abandoned: 1st Plug Set @ 950' with 70 sx. cement; 2nd Plug Set @ 200' with 40 sx. cement; 3rd Plug Set @ 40' with 10 sx. cement. State Plugger: Gilbert Balthazor. Plug was down @ 2:00 p.m. September 12, 1975.

STATE OF KANSAS)
) SS
COUNTY OF SEDGWICK)


Jerry A. Langrehr, Executive Vice President of Abercrombie Drilling, Inc., does hereby state that the above and foregoing is a true and correct copy of the log of the JOHNSON 'A-B' #1, A/C SE NE SE Section 4-8S-23W, Graham County, Kansas.

ABERCROMBIE DRILLING, INC.

By: *Jerry A. Langrehr*

Subscribed and sworn to before me, a Notary Public, in and for the aforesaid county and state as of this 16th day of September, 1975.

Sandra Russell
Sandra Russell-Notary Public

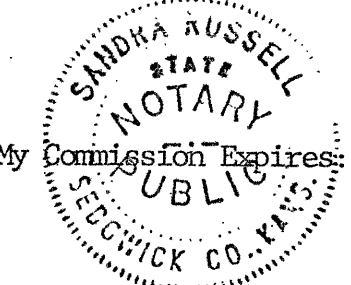

My Commission Expires: July 21, 1975

RECORDED
SEP 17 1975
9-17-75