


STATE OF KANSAS  
STATE CORPORATION COMMISSION

15-065-00916-00-00

Give All Information Completely  
Make Required Affidavit  
Mail or Deliver Report to:  
Conservation Division  
State Corporation Commission  
211 No. Broadway  
Wichita, Kansas

WELL PLUGGING RECORD

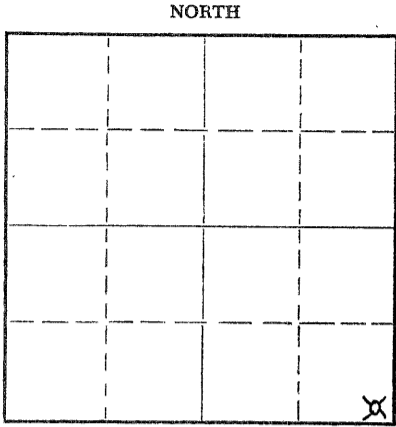

Graham County. Sec. 5 Twp. 8S Rge. 23W (E) (W)  
Location as "NE/CNW/SW" or footage from lines SE SE SE  
Lease Owner Bankoff Oil Company  
Lease Name Kipper Well No. 1  
Office Address Box 2479, Tulsa, Oklahoma  
Character of Well (completed as Oil, Gas or Dry Hole) Dry Hole  
Date well completed 5-14-19 56  
Application for plugging filed 5-14-19 56  
Application for plugging approved 5-14-19 56  
Plugging commenced 5-14-19 56  
Plugging completed 5-14-19 56  
Reason for abandonment of well or producing formation Dry Hole

Locate well correctly on above  
Section Plat

If a producing well is abandoned, date of last production \_\_\_\_\_ 19\_\_\_\_  
Was permission obtained from the Conservation Division or its agents before plugging was commenced? Yes

Name of Conservation Agent who supervised plugging of this well Eldon R. Petty  
Producing formation \_\_\_\_\_ Depth to top \_\_\_\_\_ Bottom \_\_\_\_\_ Total Depth of Well 4018 Feet  
Show depth and thickness of all water, oil and gas formations.

OIL, GAS OR WATER RECORDS

CASING RECORD

FORMATION	CONTENT	FROM	TO	SIZE	PUT IN	PULLED OUT
				8 5/8"	166'	

Describe in detail the manner in which the well was plugged, indicating where the mud fluid was placed and the method or methods used in introducing it into the hole. If cement or other plugs were used, state the character of same and depth placed, from \_\_\_\_\_ feet to \_\_\_\_\_ feet for each plug set.

Plugged with 160' mud, 1/2 sk hulls,  
15 sks cement. Fill to 40' with mud,  
1/2 sk hulls, 10 sks cement to surface.

(If additional description is necessary, use BACK of this sheet)

Name of Plugging Contractor Leben Drilling, Inc.  
Address 505 Orpheum Bldg, Wichita 2, Kansas

STATE OF KANSAS, COUNTY OF SEDGWICK, ss.

I, James M. Battin (employee of owner) or (~~owner or operator~~) of the above-described well, being first duly sworn on oath, says: That I have knowledge of the facts, statements, and matters herein contained and the log of the above-described well as filed and that the same are true and correct. So help me God.

(Signature) James M. Battin  
Wichita, Kansas  
(Address)

SUBSCRIBED AND SWORN TO before me this 15th day of May, 19 56

Kenna D. Sisson  
Notary Public.

My commission expires April 20, 1959

PLUGGING  
FILE SEC 5 T 8 R 23W  
BOOK PAGE 61 LINE 32

RECEIVED  
MAY 14 1956  
5-16-56  
CONSERVATION DIVISION  
Wichita, Kansas

15-065-00916-00-00

CONTRACTOR'S WELL LOG

COMPANY: Bankoff Oil Company  
 CONTRACTOR: Leben Drilling, Inc.  
 FARM: KIPPER NO. 1  
 LOCATION: SE SE SE Sec. 5-8S-23W,  
 Graham County, Kansas  
 COMMENCED: May 5, 1956  
 COMPLETED: May 14, 1956

0	135	Surface
135	166	Shale, shells
166	982	Shale
982	1515	Shale, shells
1515	1735	Sand
1735	1855	Shale
1855	1977	Shale, redbed
1977	2008	Anhydrite
2008	2108	Shale
2108	2418	Shale, lime
2418	2655	Lime, shale
2655	3043	Lime, shale
3043	3304	Shale, lime
3304	3520	Lime, shale
3520	3547	Shale, lime
3547	3587	Lime, shale
3587	3620	Lansing Lime
3620	3727	Lime
3727	3765	Shale, lime
3765	3802	Lime
3802	3897	Shale, lime
3897	3972	Lime, shale
3972	3981	Shale, lime
3981	3993	Conglomerate
3993	4018	Arbuckle
	<u>4018</u>	<u>Rotary Total Depth, D &amp; A.</u>

Set 8 5/8" surface casing at 166 feet, 125 sacks cement.

I, James M. Battin, do hereby certify that the above and foregoing is a true and correct copy of the log of the Kipper No. 1, SE SE SE Sec. 5-8S-23W, Graham County, Kansas, as reflected by the files of Leben Drilling, Inc.

LEBEN DRILLING, INC.

BY: James M. Battin

STATE OF KANSAS )  
COUNTY OF SEDGWICK ) SS

Subscribed and sworn to before me, a Notary Public, in and for Sedgwick County, Kansas, this 15th day of May, 1956.

Anna A. Lison  
Notary Public

My commission expires April 20, 1959

PLUGGING			
FILE	SEC	T	R
	5	8	23W
BOOK	PAGE	LINE	
	61	32	

51656