

15-005-20262-00-00


STATE OF KANSAS
STATE CORPORATION COMMISSION

Form CP-4

WELL PLUGGING RECORD

Give All Information Completely
Make Required Affidavit
Mail or Deliver Report to:
Conservation Division
State Corporation Commission
212 No. Market
Wichita, Kansas

NORTH

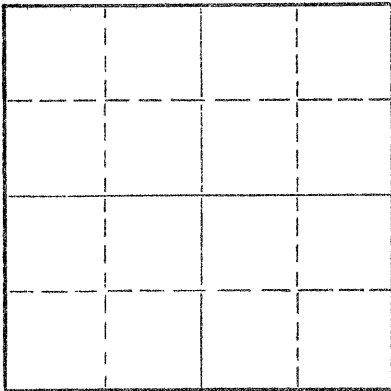

Locate well correctly on above
Section Plat

Graham County, Sec. 21 Twp. 8S Rge. (E) 22 (W)

Location as "NE/CNW/SW" or footage from lines C SE NE

Lease Owner Imperial Oil Co.

Lease Name Fink Well No. 1

Office Address 780 Fourth National Bldg., Wichita, Kansas

Character of Well (completed as Oil, Gas or Dry Hole) Dry Hole

Date well completed 9-25 19 69

Application for plugging filed 9-25 19 69

Application for plugging approved 9-25 19 69

Plugging commenced 9-25 19 69

Plugging completed 9-25 19 69

Reason for abandonment of well or producing formation No commercial quantities of oil and/or gas were encountered.

If a producing well is abandoned, date of last production 19

Was permission obtained from the Conservation Division or its agents before plugging was commenced? yes

Name of Conservation Agent who supervised plugging of this well W. L. Nichols, Moreland, Kansas

Producing formation _____ Depth to top _____ Bottom _____ Total Depth of Well 3600 Feet

Show depth and thickness of all water, oil and gas formations.

OIL, GAS OR WATER RECORDS

CASING RECORD

FORMATION	CONTENT	FROM	TO	SIZE	PUT IN	PULLED OUT
Surface casing			209'	8 5/8	185 sacks-	Not pulled

Describe in detail the manner in which the well was plugged, indicating where the mud fluid was placed and the method or methods used in introducing it into the hole. If cement or other plugs were used, state the character of same and depth placed, from 3600 feet to _____ feet for each plug set.

Set first plug at 900 feet with 100 sacks cement.

Set second plug at 215 feet with 20 sacks cement.

Set third plug at 40 feet with 10 sacks cement.

RECEIVED
STATE CORPORATION COMMISSION
OCT 2 1969
CONSERVATION DIVISION
Wichita, Kansas

16-2-69

(If additional description is necessary, use BACK of this sheet)

Name of Plugging Contractor Imperial Oil Company
Address 780 Fourth National Bldg., Wichita, Kansas 67202

STATE OF KANSAS COUNTY OF SEDGWICK, ss.
Charley V. Shank

(employee of owner) or (owner or operator) of the above-described well, being first duly sworn on oath, says: That I have knowledge of the facts, statements, and matters herein contained and the log of the above-described well as filed and that the same are true and correct. So help me God. IMPERIAL OIL COMPANY

(Signature)

Charley V. Shank
780 Fourth National Bldg., Wichita Ks.
(Address)

SUBSCRIBED AND SWORN TO before me this 26th day of September, 19 69

My commission expires

March 3, 1970

Mary J. Brown
Notary Public.

Notary Public.

DRILLER'S LOG

15-065-20262-00-00

Imperial Oil Company
780 Fourth National Bldg.
Wichita, Kansas 67202

#1 Fink
C SE NE Sec. 21-8S-22W
Graham County, Kansas

Total Depth: 3600 ft.

Elevation: 2122 K.B.

Commenced: September 18, 1969

Completed: September 25, 1969
Dry Hole

Contractor: Imperial Oil Co., Rig #2

Casing Record: Set 8 5/8 inch surface casing at 209 feet with 185 sacks of cement.

Figures indicate bottom of formations:

	<u>Sample Tops:</u>	
70' Sand-rock	Anhydrite	1728 (+ 394)
209' Shale	Heebner	3343 (-1221)
430' Sand-shale	Toronto	3368 (-1246)
1260' Shale	Lansing	3380 (-1258)
1470' Dakota Sand	Base Kansas City	3591 (-1469)
1761' Anhydrite	Total Depth	3600 (-1478)
2110' Shale-shells		
2325' Shale		
2665' Shale-lime		
3305' Lime-shale		
3600' Lime		
<u>3600' Rotary Total Depth</u>		

RECEIVED
STATE CORPORATION COMMISSION
OCT 2 1969
CONSERVATION DIVISION
Wichita, Kansas
10-2-69

We hereby certify this to be a correct and accurate log of the above described well, as shown on the daily drilling reports.

IMPERIAL OIL COMPANY

Charley V. Shank

Subscribed and sworn to before me this 29th day of September, 1969

Mary J. Brown
Mary J. Brown, Notary Public

My Commission Expires:
March 3, 1970