


WELL PLUGGING RECORD

Give All Information Completely  
Make Required Affidavit  
Mail or Deliver Report to:  
Conservation Division  
State Corporation Commission  
211 No. Broadway  
Wichita, Kansas

Graham County, Sec. 24 Twp. 8S Rge. 22 (X) W (W)

Location as "NE/CNW/SW" or footage from lines NW NW NE  
Lease Owner Leben Drilling, Inc.  
Lease Name Kirkpatrick Well No. 1  
Office Address 905 Central Building; Wichita 2, Kansas  
Character of Well (completed as Oil, Gas or Dry Hole) Dry Hole  
Date well completed December 6 1956  
Application for plugging filed December 6 1956  
Application for plugging approved December 6 1956  
Plugging commenced December 6 1956  
Plugging completed December 6 1956  
Reason for abandonment of well or producing formation Dry

NORTH

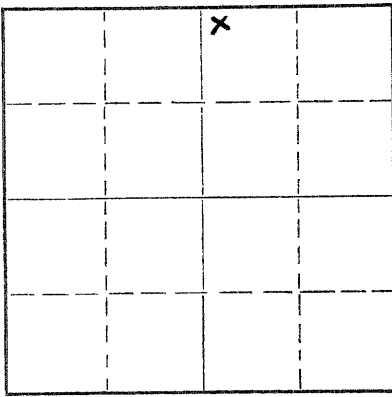

Locate well correctly on above Section Plat

If a producing well is abandoned, date of last production \_\_\_\_\_ 19\_\_\_\_  
Was permission obtained from the Conservation Division or its agents before plugging was commenced? Yes

Name of Conservation Agent who supervised plugging of this well Eldon Petty  
Producing formation \_\_\_\_\_ Depth to top \_\_\_\_\_ Bottom \_\_\_\_\_ Total Depth of Well 3707 Feet  
Show depth and thickness of all water, oil and gas formations.

OIL, GAS OR WATER RECORDS

CASING RECORD

| FORMATION | CONTENT | FROM | TO | SIZE   | PUT IN | PULLED OUT |
|-----------|---------|------|----|--------|--------|------------|
|           |         |      |    | 8 5/8" | 187'   |            |
|           |         |      |    |        |        |            |
|           |         |      |    |        |        |            |
Describe in detail the manner in which the well was plugged, indicating where the mud fluid was placed and the method or methods used in introducing it into the hole. If cement or other plugs were used, state the character of same and depth placed, from \_\_\_\_\_ feet to \_\_\_\_\_ feet for each plug set.

Mud up to 180'. Bottom Halliburton plug @ 180' with 20 sacks bulk cement.  
Top Halliburton plug @ 40' with 10 sacks bulk cement.

(If additional description is necessary, use BACK of this sheet)

Name of Plugging Contractor Kan-Tex Drillers, Inc.  
Address 413 Beacon Building; Wichita 2, Kansas

STATE OF Kansas, COUNTY OF Sedgwick, ss.  
Harvey E. Nightingale (employee of owner) or (owner or operator) of the above-described well, being first duly sworn on oath, says: That I have knowledge of the facts, statements, and matters herein contained and the log of the above-described well as filed and that the same are true and correct. So help me God.

(Signature) Harvey E. Nightingale  
413 Beacon Building; Wichita 2, Kansas  
(Address)

SUBSCRIBED AND SWORN TO before me this 7th day of December, 1956

Frances E. Krenke  
Notary Public.

My commission expires November 8, 1960

PLUGGING  
FILE SEC 24 T 8 R 22W  
BOOK PAGE 123 LINE 27

Rec'd  
12-08-1956

15-065-30355-00-00

DRILLERS' LOG

No. 1 Kirkpatrick  
NW NW NE of Section 24-8S-22W  
Graham County, Kansas

| FROM | TO   |                          |
|------|------|--------------------------|
| 0    | 188  | Surface, sand, shale     |
| 188  | 1185 | Shale and sand           |
| 1185 | 1400 | Sand                     |
| 1400 | 1675 | Red Bed                  |
| 1675 | 1705 | Anhydrite                |
| 1705 | 2995 | Shale and shells         |
| 2995 | 3330 | Shale and lime           |
| 3330 | 3585 | Lime and shale           |
| 3585 | 3630 | Shale and lime           |
| 3630 | 3663 | Conglomerate             |
| 3663 | 3707 | Lime                     |
|      | 3707 | Rotary Total Depth D & A |

COMMENCED: 11-28-1956

COMPLETED: 12-6-1956

CASING RECORD:

Set 8 5/8" surface casing  
at 187' with 160 sacks  
bulk cement, 2% Calcium  
Chloride.

STATE OF KANSAS )  
                          ) S S  
COUNTY OF SEDGWICK)

I hereby affirm that the above and foregoing is a true and correct copy of the formations encountered on the No. 1 Kirkpatrick, NW NW NE of Section 24-8S-22W, Graham County, Kansas, as reflected by the daily drilling reports.

KAN-TEX DRILLERS, INC.

By: Harvey E. Nightingale  
Harvey E. Nightingale

Subscribed and sworn to before me this 7th day of December 1956

Frances E. Kisenbae  
Notary Public

My Commission Expires: November 9, 1960

PLUGGING  
FILE SEC 24 T 8 R22W  
BOOK PAGE 123 LINE 27