


STATE OF KANSAS
STATE CORPORATION COMMISSION

15-065-00521-00-00
WELL PLUGGING RECORD

Give All Information Completely
Make Required Affidavit
Mail or Deliver Report to:
Conservation Division
State Corporation Commission
800 Bitting Building
Wichita, Kansas

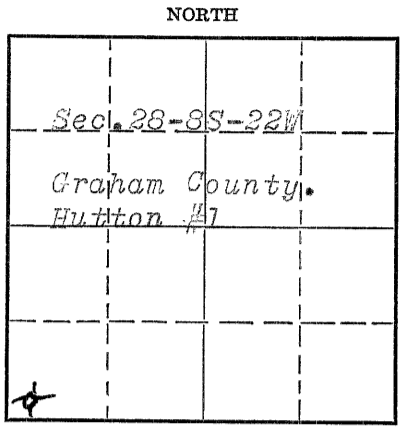

Location as "NE/CNW $\frac{1}{4}$ SW $\frac{1}{4}$ " or footage from lines C-SW-SW-SW
Lease Owner Lee Phillips Oil Company
Office Address Union Nat'l Bank Bldg., Wichita, Kansas.
Character of Well (completed as Oil, Gas or Dry Hole) Dry Hole
Date well completed 4-23-51 19 51
Application for plugging filed 4-23-51 19 51
Application for plugging approved 4-23 19 51
Plugging commenced 4-23 19 51
Plugging completed 4-23 8:00 AM. 19 51
Reason for abandonment of well or producing formation Dry Hole

If a producing well is abandoned, date of last production _____ 19____
Was permission obtained from the Conservation Division or its agents before plugging was commenced? yes Verbal

Name of Conservation Agent who supervised plugging of this well Eldon Petty
Producing formation _____ Depth to top _____ Bottom _____ Total Depth of Well 3900 Feet
Show depth and thickness of all water, oil and gas formations.

OIL, GAS OR WATER RECORDS

CASING RECORD

Formation	Content	From	To	Size	Put In	Pulled Out
<u>Soil, shale & shells</u>		<u>0</u>	<u>157'</u>	<u>2 5/8"</u>	<u>157'</u>	<u>none</u>
<u>Kansas City</u>		<u>3452'</u>	<u>3671'</u>		<u>dry</u>	<u>Dry</u>
<u>Arbuckle</u>		<u>3863'</u>	<u>3900'</u>		<u>dry</u>	<u>dry</u>

Describe in detail the manner in which the well was plugged, indicating where the mud fluid was placed and the method or methods used in introducing it into the hole. If cement or other plugs were used, state the character of same and depth placed, from _____ feet to _____ feet for each plug set.

Stirred pits with heavy mud. Placed bottom wood plug at 156 feet and ran 15 sacks cement through drill pipe. Filled hole with mud to 40 feet. Placed top wood plug at 40 feet with 1/2 sack hulls, and ran 10 sacks cement, filling hole to bottom of cellar.

(If additional description is necessary, use BACK of this sheet)

Correspondence regarding this well should be addressed to Strain Drilling Company
Address Box 188 Hays, Kansas.

STATE OF Kansas, COUNTY OF Ellis, ss.
T.C. Strain (employee of owner) or (owner or operator) of the above-described well,


being first duly sworn on oath, says: That I have knowledge of the facts, statements, and matters herein contained and the log of the above-described well as filed and that the same are true and correct. So help me God.

(Signature) T.C. Strain

Box 188, Hays, Kansas.
(Address)

SUBSCRIBED AND SWORN to before me this 24th day of April, 19 51

My commission expires March 1, 1954
LeRoy D. Power Notary Public.

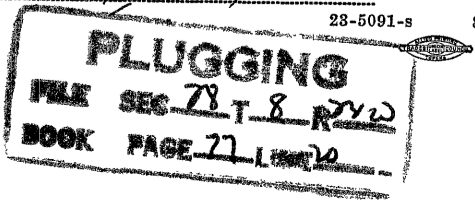

WELL LOG

COMPANY: Lee Phillips Oil Co.

LEASE: Hutton #1

15-065-60521-00-00

C-SW-SW SW, Sec. 28
Twp. 35, Rge. 22W,
Graham County, Ks.

ELEVATION: 2192 Derrick Floor

NOTE: All meas. rotary bushings.

0	157 Shale & shells
157	790 Shale & shells
790	900 Sand
900	1057 Shale & sand
1057	1310 Shale & shells
1310	1525 Sand
1525	1575 Redbed
1575	1775 Redbed & shale
1775	1820 Anhydrite
1820	1930 Shale & shells
1930	2185 Shale & shells
2185	2230 Lime & shale
2230	2400 Lime & shale
2400	2525 Lime & shale
2525	2695 Lime & shale
2695	2820 Lime
2820	2900 Lime
2900	3040 Lime
3040	3155 Shale & shells
3155	3260 Shale & lime
3260	3350 Shale & lime
3350	3435 Lime
3435	3475 Lime
3475	3508 Lime
3508	3545 Lime
3545	3590 Lime
3590	3634 Lime
3634	3670 Lime
3670	3740 Shale & lime
3740	3770 Shale & Lime
3770	3815 Shale
3815	3850 Conglomerate
3850	3863 Conglomerate
3863	3900 Arbuckle
3900 (T.D.)	R.B.

COMMENCED: 4-13-51
COMPLETED: 4-23-51

CASING RECORD:

8 5/8" Surface casing set at
157' w/100 sacks cement by
Globe Cementing Co.

No Drill Stem tests or
Electric Log run.

TOPS

Anhydrite	1775	Lansing (K.C.)	3432
Topeka	3200	Base K.C.	3671
Heebner	3413	Conglomerate	3815
Toronto	3437	Arbuckle	3863
		Total Depth	3900

STATE OF KANSAS)
)SS
COUNTY OF ELLIS)

I hereby affirm that the above and foregoing is a true and correct copy of the log of the Hutton #1, located C-SW-SW-SW, Sec. 28, Twp. 35, Rge. 22W, Graham County, Kansas.

PLUGGING
BOOK PAGE 77

CONTRACTOR: Strain Drilling Company

BY T.O. Strain
T.O. Strain

Subscribed and sworn to before this 24th day of April, 1951.

My Commission expires March 1, 19 54.

Leroy R. Power
NOTARY PUBLIC.