


STATE OF KANSAS
STATE CORPORATION COMMISSION

WELL PLUGGING RECORD

Give All Information Completely
Make Required Affidavit
Mail or Deliver Report to:
Conservation Division
State Corporation Commission
800 Biting Building
Wichita, Kansas

Graham County, Sec. 27 Twp. 8S Rge. (E) 22 (W)

Location as "NE/CNW¹/₄SW¹/₄" or footage from lines SE-NE-SW
Lease Owner The Carter Oil Company
Lease Name Charles & Ehel Hocker Well No. 1
Office Address Box 786 - Great Bend, Kansas
Character of Well (completed as Oil, Gas or Dry Hole) Dry Hole
Date well completed 1-14-53 19
Application for plugging filed 1-15-53 19
Application for plugging approved 1-15-53 19
Plugging commenced 1-16-53 19
Plugging completed 1-24-53 19
Reason for abandonment of well or producing formation Dry Hole

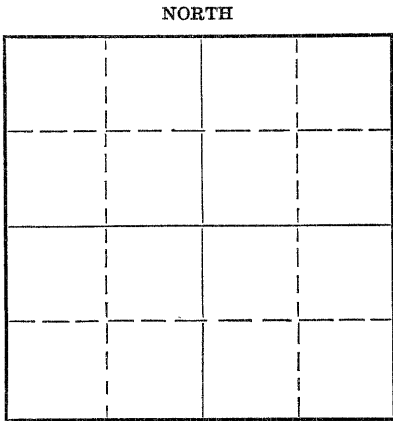

Locate well correctly on above Section Plat

If a producing well is abandoned, date of last production 19
Was permission obtained from the Conservation Division or its agents before plugging was commenced? Yes

Name of Conservation Agent who supervised plugging of this well Eldon Petty
Producing formation None Depth to top Bottom Total Depth of Well 3777 Feet
Show depth and thickness of all water, oil and gas formations.

OIL, GAS OR WATER RECORDS

CASING RECORD

Formation	Content	From	To	Size	Put In	Pulled Out
Kansas City	Dry	3440	3605	8 5/8"	205'	
Marmathon	Dry	3642	3696	5 1/2"	3792	1501'
Arbuckle	Dry	3766	3769'			

Describe in detail the manner in which the well was plugged, indicating where the mud fluid was placed and the method or methods used in introducing it into the hole. If cement or other plugs were used, state the character of same and depth placed, from feet to feet for each plug set.

Mud 3777' to 211'
Cement 211' to 35'
Mud 35' to 20'
Cement 20' to Base of Cellar

mar 5th 1953

Name of Plugging Contractor J & M Casing Pulling Company
Address Box 781
Great Bend, Kansas

STATE OF Kansas, COUNTY OF Barton, ss.
(employee of owner) or (owner or operator) of the above-described well,
being first duly sworn on oath, says: That I have knowledge of the facts, statements, and matters herein contained and the log of the above-described well as filed and that the same are true and correct. So help me God.

(Signature) W. J. Marshall (Dist. Supt.)
Box 786 - Great Bend, Kansas
(Address)

SUBSCRIBED AND SWORN to before me this 3 day of March, 1953

My commission expires July 29, 1954
My commission expires
Notary Public.

PLUGGING
FILE SEC 27 T 8 R 222
BOOK PAGE 75 LINE 14

State

WELL LOG

Carter Oil Company
P. O. Box 786
Great Bend, Kansas

Chas. Becker #1
SE 1/4 Sec 27
Section 27-63-22N
Graham County, Kansas

Total Depth: 3769'
Elevation: 2181 D. F.
Commenced: December 1, 1952
Completed: December 15, 1952
Contractor: J. D. Ferrell Drilling Co., Inc.
Rotary: O - 3769' T. D.

Casing Record: 212.98' of 8 5/8" 25.55# casing (11 joints); cemented at 211' with 125 sacks bulk cement and 1 sack calcium chloride; cement circulated.

Figures Indicate Bottoms of Formations:

Cellar	0 - 4
Sand and Clay	4 - 40
Sand and Shale	40 - 100
Shale	100 - 214
Shale and Shells	214 - 680
Shale	680 - 990
Sand	990 - 1150
Shale and Shells	1150 - 1205
Sand, Red Bed and Shale	1205 - 1540
Red Bed and Shale	1540 - 1705
Shale and Shells	1705 - 1870
Shale and Lime	1870 - 2080
Lime and Shale	2080 - 2100
Lime	2100 - 2175
Lime and Shale	2175 - 2355
Lime	2355 - 2440
Lime and Shale	2440 - 2560
Shale and Lime	2560 - 2710
Lime and Shale	2710 - 2825
Lime	2825 - 3330
Lime and Shale	3330 - 3395
Lime	3395 - 3750
Conglomerate	3750 - 3765
Lime	3765 - 3769 Total Depth

Top:

Hebner	3388	-1207
Dodge	3411	-1233
Lanning K.C.	3433	-1251
Artuckle	3761	-1583

We hereby certify this to be a correct and accurate log of the above-described well as shown on the Daily Drilling Reports.

J. D. FERRELL DRILLING CO., INC.

J. D. Ferrell
J. D. Ferrell

Subscribed and sworn to before me this 17th day of December, 1952.

Emma Jean Sayre
Emma Jean Sayre
Notary Public

My commission expires August 29, 1955.

Received:
JAN 31st, 1953

PLUGGING

FILE sec 27 T 2 R 22 W

BOOK PAGE 25 LINE 14