


STATE OF KANSAS
STATE CORPORATION COMMISSION

WELL PLUGGING RECORD

Give All Information Completely
Make Required Affidavit
Mail or Deliver Report to
Conservation Division
State Corporation Comm.
245 North Water
Wichita, KS 67202

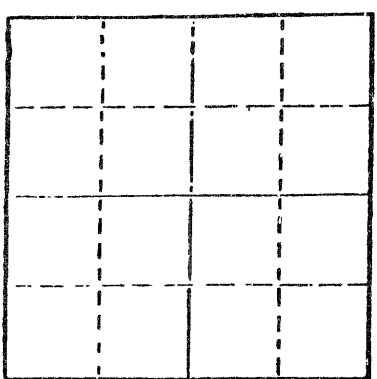

Locate well correctly on above
Section Plat

Graham County, Sec. 27 Twp. 8 Rge. 22 XX/W
Location as "NE/CNW $\frac{1}{4}$ SW $\frac{1}{4}$ " or footage from lines
NE NW SE

Lease Owner Colorado Crude Exploration, Inc.
Lease Name Fink Well No. 1
Office Address 12395 W. 53rd, Arvada, CO 80002
Character of Well (Completed as Oil, Gas or Dry Hole) Dry Hole

Date Well completed 12-24 19 80
Application for plugging filed 12-24 19 80
Application for plugging approved 12-24 19 80
Flugging commenced 12-24 19 80
Plugging completed 12-24 19 80
Reason for abandonment of well or producing formation Dry hole

If a producing well is abandoned, date of last production 19

Was permission obtained from the Conservation Division or its agents before plugging was commenced? Yes

Name of Conservation Agent who supervised plugging of this well Gilbert Balthazor
Producing formation _____ Depth to top _____ Bottom _____ Total Depth of Well 3850
Show depth and thickness of all water, oil and gas formations.

OIL, GAS OR WATER RECORDS

CASING RECORD

FORMATION	CONTENT	FROM	TO	SIZE	PUT IN	PULLED OUT
				8-5/8	375	-0-

Describe in detail the manner in which the well was plugged, indicating where the mud fluid was placed and the method or methods used in introducing it into the hold. If cement or other plugs were used, state the character of same and depth placed, from _____ feet to _____ feet for each plug set.

Mud laden fluid 3850-375'
70 sks cement @ 800'
25 sks cement @ 360'
10 sks cement @ 40'
5 sks cement in rat hole

(If additional description is necessary, use BACK of this sheet)

Name of Plugging Contractor Emphasis Oil Operations

STATE OF KANSAS COUNTY OF RUSSELL, ss.
Joe K. Branum (employee of owner) or (owner or operator)

of the above-described well, being first duly sworn on oath, says: That I have knowledge of the facts, statements, and matters herein contained and the log of the above-described well as filed and that the same are true and correct. So help me God.

(Signature) Joe K. Branum
Box 506, Russell, KS 67665 (Address)

SUBSCRIBED AND SWORN TO before me this 5th day of January 19 81

Glenda R. Tiffin
Notary Public.

My commission expires February 6, 1984



EMPHASIS OIL OPERATIONS

P.O. Box 506
Russell, Kansas 67665

DRILLERS LOG

OPERATOR: Colorado Crude Exploration, Inc.
12395 W. 53rd
Arvada, Colorado 80002

CONTRACTOR: Emphasis Oil Operations
P. O. Box 506
Russell, Kansas 67665

LEASE: Fink WELL: #1

LOCATION: NE NW SE
Section 27-8-22
Graham County, Kansas

Total Depth: 3850'

Elevation:

Commenced: 12-12-80

Completed: 12-24-80

Casing: 8-5/8" @ 375'

Status: Dry Hole

DEPTHS & FORMATIONS

(All measurements from K.B.)

Soil & clay	30	Shale & sand	2135
Sand & shale	1140	Shale	2440
Shale & sand	1776	Shale & lime	3290
Anhydrite	1811	Lime & shale (R.T.D.)	3850

STATE OF KANSAS)
COUNTY OF RUSSELL) ss

I, Joe K. Branum, of Emphasis Oil Operations, state that the above and foregoing is a true and correct log of the above captioned well.

Joe K. Branum

Joe K. Branum

Subscribed and sworn to before me this 5th day of January, 1981.
My Commission Expires: February 6, 1984.

JAN 6 1981
JAN 6 1981
EXPLORATION DIVISION
Russell, Kansas

GLENDA R. TIFFIN
Notary Public
Russell County, KS.
My Appt. Exp. 2-6-84

Glenda R. Tiffin

Notary Public