


15-173-02059-00-01

STATE OF KANSAS
STATE CORPORATION COMMISSION

WELL PLUGGING RECORD

Give All Information Completely
Make Required Affidavit
Mail or Deliver Report to:
Conservation Division
State Corporation Commission
800 Bittling Building
Wichita, Kansas

Sedgwick County. Sec. 11 Twp. 27S Rge. 2E (E) (W)
Location as "NE/CNW $\frac{1}{4}$ SW $\frac{1}{4}$ " or footage from lines SE NW SE
Lease Owner A. D. Allison et al
Lease Name Fulk Well No. 2
Office Address 715 Brown Building, Wichita 2, Kansas
Character of Well (completed as Oil, Gas or Dry Hole) Salt Wtr. Disp. Well
Date well completed 5-4-1951
Application for plugging filed 6-25-1952
Application for plugging approved " 19
Plugging commenced 6-28-1952
Plugging completed 19
Reason for abandonment of well or producing formation No longer needed
as salt water disposal well
If a producing well is abandoned, date of last production 19
Was permission obtained from the Conservation Division or its agents before plugging was commenced? Yes

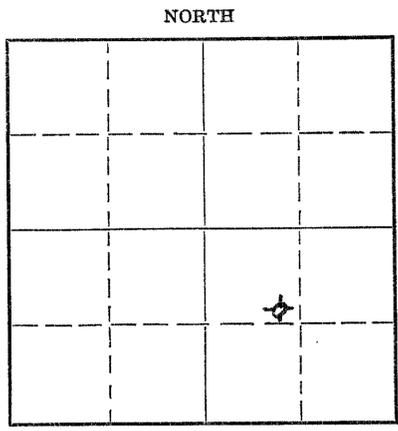

Locate well correctly on above Section Plat

Name of Conservation Agent who supervised plugging of this well _____
Producing formation _____ Depth to top _____ Bottom _____ Total Depth of Well 4035 Feet
Show depth and thickness of all water, oil and gas formations.

OIL, GAS OR WATER RECORDS

CASING RECORD

Formation	Content	From	To	Size	Put In	Pulled Out
				8-5/8	120	none

Describe in detail the manner in which the well was plugged, indicating where the mud fluid was placed and the method or methods used in introducing it into the hole. If cement or other plugs were used, state the character of same and depth placed, from _____ feet to _____ feet for each plug set.
Sand 4100 to 3335. 3 sacks cement at 3335. Mud to 130.
Cement 130 to 100. Mud to 10'. Rock and cement to surface.

(If additional description is necessary, use BACK of this sheet)

Name of Plugging Contractor A. D. Allison & Co., Inc.,
Address 715 Brown Building, Wichita 2, Kansas.

STATE OF Kansas, COUNTY OF Sedgwick, ss.
J. A. ALLISON (employee of owner) or (owner or operator) of the above-described well, being first duly sworn on oath, says: That I have knowledge of the facts, statements, and matters herein contained and the log of the above-described well as filed and that the same are true and correct. So help me God.

(Signature) J. A. Allison
715 Brown Bldg., Wichita 2, Kansas
(Address)

SUBSCRIBED AND SWORN to before me this 23 day of July, 1952

My commission expires 7-22-53

W. Lee Johnson
Notary Public.

23-8390-s 6-51-20M
PLUGGING
FILE REC 11 T 27 R 2E
BOOK PAGE 26 LINE 19

RECEIVED
STATE CORPORATION COMMISSION
JUL 27 1952
7-24-52
CONSERVATION DIVISION
Wichita, Kansas

A. D. ALLISON et al
#2 FULK

Sec. 11, Twp. 27S., Rge. 2E.,
Sedgwick County, Kansas.

Total Depth: 3310'
Comm: 4-18-51
Comp: 5-4-51
CONTR: A. D. ALLISON & CO., INC.
Elevation: 1348 R. B.

SE NW SE

PRODUCTION: D & A

CASING RECORD:

8-5/8" 120'

FORMATION

DEPTH

S. W. D. W.

Shale and lime	120
Lime and shale	295
Anhydrite	325
Lime and shale	370
Sand	415
Shale	450
Sand	520
Lime and shale	1005
Shale and shells	1160
Lime, broken	1290
Lime and shale	1380
Shale and shells	1470
Lime and shale	1620
Broken lime	1650
Lime and shale	2220
Lime	2260
Lime and shale	2405
Kansas City lime	2460
Lime	2520
Lime and shale	2863
Lime, Mississippi	3105
Lime and shale	3164
Lime, Viola	3200
Sand, Simpson	3242
Shale, lime and sand	3270
Lime and shale	3280
Sand	3285
Shale	3290
Lime, Arbuckle	3310 - T. D.

FORMATION

DEPTH

Lime, Arbuckle	3320
Lime	3395
Lime and chert	3425
Lime	3480
Lime and chert	3515
Lime	3540
Lime and chert	3680
Lime	3700
Lime and chert	3850
Lime and shale streaks	3862
Lime and chert	3999
Granite	4020
Lime	4035 - T. D.


5 1/2" set at 3340.
Cemented with 50 sacks cement.

TOPS:

K. C. Limestone	2405
Mississippi	2863
Kinderhook	3076
Viola	3164
Simpson Dol.	3190
Arbuckle	3290

Certified true copy of drillers log.

By A. D. Allison

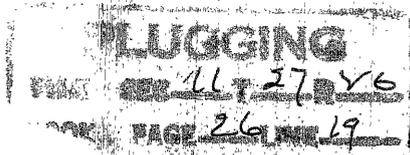

RECEIVED
STATE COMMISSION OF CONSERVATION
JUN 26 1952
CONSERVATION DIVISION
Wichita, Kansas