


STATE OF KANSAS
STATE CORPORATION COMMISSION

WELL PLUGGING RECORD

Give All Information Completely
Make Required Affidavit
Mail or Deliver Report to:
Conservation Division
State Corporation Commission
800 Bitting Building
Wichita, Kansas

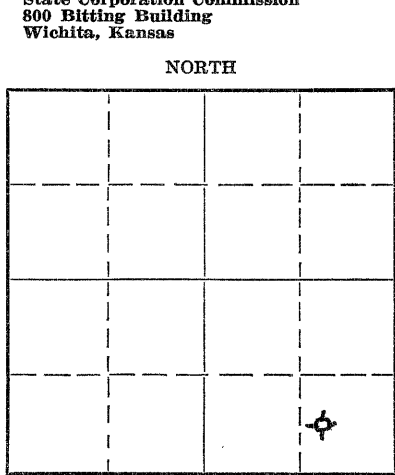

Locate well correctly on above Section Plat

Sedgwick County. Sec. 11 Twp 27S Rge 2E (E) (W)
 Location as "NE/CNW 1/4 SW 1/4" or footage from lines Center West East
 Lease Owner A. D. Allison et al
 Lease Name Fulk Well No. 3
 Office Address 715 Brown Building, Wichita 2, Kansas
 Character of Well (completed as Oil, Gas or Dry Hole) Dry Hole
 Date well completed 12-6 19 51
 Application for plugging filed " 19
 Application for plugging approved " 19
 Plugging commenced " 19
 Plugging completed " 19
 Reason for abandonment of well or producing formation Dry hole

If a producing well is abandoned, date of last production 19____
 Was permission obtained from the Conservation Division or its agents before plugging was commenced? Yes

Name of Conservation Agent who supervised plugging of this well D. C. Lilley
 Producing formation _____ Depth to top _____ Bottom _____ Total Depth of Well 3287 Feet
 Show depth and thickness of all water, oil and gas formations.

OIL, GAS OR WATER RECORDS

CASING RECORD

Formation	Content	From	To	Size	Put In	Pulled Out
				8-5/8	100	none

Describe in detail the manner in which the well was plugged, indicating where the mud fluid was placed and the method or methods used in introducing it into the hole. If cement or other plugs were used, state the character of same and depth placed, from _____ feet to _____ feet for each plug set.

Filled hole with heavy mud. Set bottom plug at 105 feet. Cemented with 15 sacks cement. Filled hope with heavy mud. Set top plug at 15 feet. Cemented with 10 sacks cement.

RECEIVED
 STATE CORPORATION COMMISSION
 12-8-51
 DEC - 8 1951
 CONSERVATION DIVISION
 Wichita, Kansas

(If additional description is necessary, use BACK of this sheet)
 Name of Plugging Contractor A. D. Allison & Co., Inc.,
 Address 715 Brown Building, Wichita 2, Kansas.

STATE OF Kansas, COUNTY OF Sedgwick, ss.

J. A. ALLISON (employee of owner) or (owner or operator) of the above-described well,
 being first duly sworn on oath, says: That I have knowledge of the facts, statements, and matters herein contained and the log of the above-described well as filed and that the same are true and correct. So help me God

(Signature) *J. A. Allison*
 715 Brown Bldg., Wichita 2, Kansas.
 (Address)

SUBSCRIBED AND SWORN to before me this 7th day of December, 19 51

My commission expires July 22, 1953. *New School* Notary Public.

23-8390-s 6-51-20M
 RECEIVED
 11 27 AM '51
 STATE CORPORATION COMMISSION

A. D. ALLISON ET AL
#3 FULK

Sec. 11, Twp. 27S., Rge. 2E.,
Sedgwick County, Kansas.

Total depth: 3287'
Comm: 11-20-51
Comp: 12-6-51
CONTR: A. D. ALLISON & CO., INC.,
Log issued: 12-7-51

Center $W\frac{1}{2}$ $SE\frac{1}{4}$ $SE\frac{1}{4}$
Elevation 1351 R. B.

D & A

CASING RECORD:

8-5/8 100'

FORMATION

DEPTH

Lime	605
Shale and lime	855
Shale and shells	1125
Shale and limestone	1347
Lime and shale	2403
Kansas City lime	2610
Shale	2661
Shale and lime	2829
Shale, sandy	2887
Lime and chert (Miss.)	2941
Lime	3077
Lime and shale	3116
Shale	3162
Shale and lime	3200
Lime and sand	3238
Shale and lime	3262
Sand and shale	3271
Lime, Arbuckle	3287 - T. D.

TOPS:

Kansas City	2409
Mississippian	2879
Viola	3159
Simpson dolomite	3180
Arbuckle	3270

