


STATE OF KANSAS
STATE CORPORATION COMMISSION
Give All Information Completely
Make Required Affidavit
Mail or Deliver Report to:
Conservation Division
State Corporation Commission
800 Bitting Building
Wichita, Kansas

WELL PLUGGING RECORD

Sedgwick County. Sec. 11 Twp. 27S Rge. 2E (E).....(W)
Location as "NE/CNW $\frac{1}{4}$ SW $\frac{1}{4}$ " or footage from lines SE SE NW
Lease Owner A. D. Allison et al
Lease Name Plummer Well No. 1
Office Address 715 Brown Building, Wichita, Kansas
Character of Well (completed as Oil, Gas or Dry Hole) ..
Date well completed..... 8-28- 1951
Application for plugging filed..... " 19
Application for plugging approved..... " 19
Plugging commenced..... " 19
Plugging completed..... " 19
Reason for abandonment of well or producing formation..... Dry - Tested
not commercial on pump.
If a producing well is abandoned, date of last production..... 19
Was permission obtained from the Conservation Division or its agents before plugging was com-
menced?..... Yes

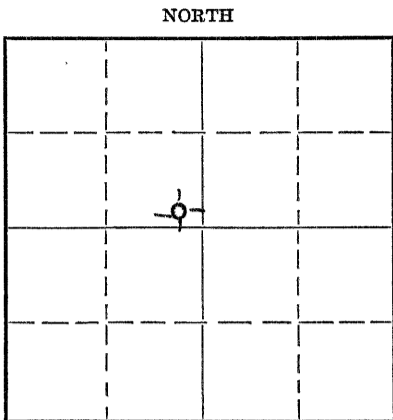

Locate well correctly on above Section Plat

Name of Conservation Agent who supervised plugging of this well..... D. C. Lilley
Producing formation..... Depth to top..... Bottom..... Total Depth of Well..... 3315 Feet
Show depth and thickness of all water, oil and gas formations.

OIL, GAS OR WATER RECORDS

CASING RECORD

Formation	Content	From	To	Size	Put In	Pulled Out
<u>Sand</u>	<u>Water</u>	<u>55</u>	<u>62</u>	<u>8-5/8</u>	<u>120</u>	

Describe in detail the manner in which the well was plugged, indicating where the mud fluid was placed and the method or methods used in introducing it into the hole. If cement or other plugs were used, state the character of same and depth placed, from..... feet to..... feet for each plug set.

Filled hole with heavy mud. Pushed bottom plug to 150 feet. 15 feet of rock on top of plug and 15 sacks cement on top of rock. Filled hole with heavy mud to 10 feet. Set top plug at 10 feet. 5 sacks cement on top of plug to surface.

RECEIVED
STATE CORPORATION COMMISSION
8-31-51
AUG 31 1951
CONSERVATION DIVISION
Wichita, Kansas

(If additional description is necessary, use BACK of this sheet)
Correspondence regarding this well should be addressed to A. D. Allison & Co., Inc.
Address 715 Brown Building, Wichita 2, Kansas.

STATE OF Kansas, COUNTY OF Sedgwick, ss.
J. A. Allison (employee of owner) or (owner or operator) of the above-described well,
being first duly sworn on oath, says: That I have knowledge of the facts, statements, and matters herein contained and the log of the above-described well as filed and that the same are true and correct. So help me God.

(Signature) J. A. Allison
715 Brown Building, Wichita 2, Kansas
(Address)

SUBSCRIBED AND SWORN to before me this 30th day of August, 19 51

Free Schrock
Notary Public.

My commission expires 7-22-53

PLUGGING
FILE SEC 11 T 27 R 2E
BOOK PAGE 106 LINE 30

A. D. ALLISON ET AL
#1 PLUMMER

Sec. 11, Twp. 27S., Rge. 2E.

SE SE NW

Total Depth 3315'

Comm: 5-23-51

Comp: 6-5-51

Sedgwick County, Kansas.

CONTR: A. D. ALLISON & CO., INC.,

~~PLUGGING~~

CASING RECORD:

8-5/8 120'

FORMATION

DEPTH

Shale and clay	55
Sand	62
Lime	120
Lime and shale	370
Sand	400
Lime and shale	485
Shale and lime	950
Shale and shells	1115
Shale and lime	1440
Shale and shells	1590
Shale and lime	1980
Lime and shale	2260
Lime	2295
Shale and lime	2324
Lime and shale	2415
Lime, Kansas City	2720
Lime and shale	2870
Lime	3030
Lime and shale	3155
Shale	3173
Lime	3200
Shale	3230
Sandy shale	3278
Sand, Simpson	3290
Shale	3292
Lime, Arbuckle	3315 - T. D.

TOPS:

Kansas City limestone	2411
Mississippi	2874
Misener sand	3173
Viola	3174
Simpson dolomite	3194
Arbuckle	3292

SEARCHED
INDEXED
AUG 31 1951
CORRELATION DIVISION
Topeka, Kansas

PLUGGING
FILE SEC 11 T 27 R 2E
BOOK PAGE 106 LINE 30