


STATE OF KANSAS  
STATE CORPORATION COMMISSION

WELL PLUGGING RECORD

Give All Information Completely  
Make Required Affidavit  
Mail or Deliver Report to:  
Conservation Division  
State Corporation Commission  
800 Bitting Building  
Wichita, Kansas

NORTH

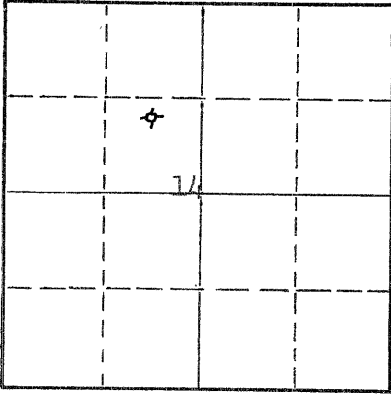

Locate well correctly on above  
Section Plat

Sedgwick County. Sec. 14 Twp. 27 Rge. 2 (E) (W)  
Location as "NE/CNW\*SW\*" or footage from lines Cen. N/2 SE/4 NW/4  
Lease Owner John P. Gaty  
Lease Name Hoult Well No. 1  
Office Address 11 Cypress Dr., Wichita, Kansas  
Character of Well (completed as Oil, Gas or Dry Hole) Dry  
Date well completed 9-25 19 53  
Application for plugging filed 9-28 19 54  
Application for plugging approved 9-28 19 54  
Plugging commenced 9-28 19 54  
Plugging completed 9-29 19 54  
Reason for abandonment of well or producing formation \_\_\_\_\_

If a producing well is abandoned, date of last production \_\_\_\_\_ 19 \_\_\_\_\_  
Was permission obtained from the Conservation Division or its agents before plugging was commenced? Yes

Name of Conservation Agent who supervised plugging of this well Ruel Durkee  
Producing formation \_\_\_\_\_ Depth to top \_\_\_\_\_ Bottom \_\_\_\_\_ Total Depth of Well 3301 Feet  
Show depth and thickness of all water, oil and gas formations.

OIL, GAS OR WATER RECORDS

CASING RECORD

FORMATION	CONTENT	FROM	TO	SIZE	PUT IN	PULLED OUT

Describe in detail the manner in which the well was plugged, indicating where the mud fluid was placed and the method or methods used in introducing it into the hole. If cement or other plugs were used, state the character of same and depth placed, from \_\_\_\_\_ feet to \_\_\_\_\_ feet for each plug set.

Mudded from 3301' to 550'  
Plug with 20 sacks of cement at 550'  
Heavy mud to 175'  
Set rock bridge with 20 sacks cement at 175'  
Mudded to surface  
5 sacks cement at surface

(If additional description is necessary, use BACK of this sheet)

Name of Plugging Contractor John P. Gaty  
Address 11 Cypress Dr., Wichita, Kansas

STATE OF Kansas, COUNTY OF Sedgwick, ss.  
Earl Wentworth (employee of owner) or (owner or operator)

well, being first duly sworn on oath, says: That I have knowledge of the facts, statements, and matters herein contained and the log of the above-described well as filed and that the same are true and correct. So help me God.

(Signature) Earl Wentworth  
734 Pippin Court, Wichita, Kansas  
(Address)

SUBSCRIBED AND SWORN TO before me this 4th day of October, 19 54

My commission expires December 12, 1955  
J. Arnold Sewell  
Notary Public.

**PLUGGING**  
FILE SEC 14 T 27 R 2E  
BOOK PAGE 66 LINE 40

10-6-54

WELL LOG - Hoult #1

OPERATOR: Mr. J. P. Gaty  
c/o Beech Aircraft Corp.  
Wichita, Kansas

LOCATION: N/2 SE NW  
Section 14-27S-2E  
Sedgwick County, Kansas

CONTRACTOR: Morrison Drilling Company, Inc.  
Drawer 712  
El Dorado, Kansas

Farm: Hoult Well No. 1

Date Commenced: September 15, 1953  
Date Completed: September 25, 1953

Total Depth: 3301 feet - Rotary


<u>From</u>	<u>To</u>	<u>Formation</u>
84	100	Cement
100	112	Lime
112	124	Shale
124	140	Lime
140	153	Broken Lime & Shale
153	173	Blue Lime
173	210	Shale
210	220	Blue Lime
220	225	Shale
225	235	Black Rock
235	242	Lime
242	254	Shale
254	262	Red Rock
262	274	Shale
274	320	Lime
320	330	Shale
330	410	Lime
410	422	Broken Lime & Shale
422	445	Shale
445	448	Lime
448	485	Shale
485	525	Lime
525	530	Shale
530	535	Red Bed
535	610	Lime
610	740	Shale & Lime
740	1065	Shale & Shells
1065	1150	Shale
1150	1190	Lime
1190	1300	Shale & Lime
1300	1360	Shale
1360	1530	Lime & Shale
1530	1580	Lime
1580	1665	Lime, Shale strks. & Anhydrite
1665	1825	Lime
1825	1910	Lime & Shale
1910	2000	Shale
2000	2214	Shale & Lime
2214	2320	Lime
2320	2444	Shale
2444	2460	Lime
2460	2512	Lime & Shale
2512	2543	Lime - K.C.
2543	2592	Lime
2592	2672	Shale
2672	2730	Lime
2730	2881	Shale & Lime
2881	2884	Chert (Top Miss.)
2884	3112	Lime
3112	3181	Shale
3181	3208	Lime & Shale
3208	3213	Sand
3213	3242	Lime & Shale
3242	3290	Sand & Shale
3290	3301	Lime
3301		Total Depth.

**PLUGGING**  
 WELL SEC 14 T 27 S 2E  
 BLOCK FACE 66 LINE 40

Well Log - Hoult #1  
Page 2

I hereby certify that the foregoing is a true and correct copy of the Well Log for the #1 Hoult well drilled for Mr. J. P. Gaty and completed September 25, 1953.

MORRISON DRILLING COMPANY, INC.

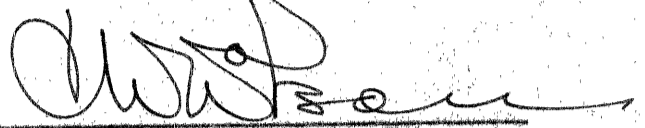

C. W. Wilson - Secretary-Treasurer

STATE OF KANSAS        )  
                              ) ss.  
COUNTY OF BUTLER    )

SUBSCRIBED AND SWORN TO, Before the Undersigned, a Notary Public, in and for the County and State aforesaid this 29th day of September, 1953.



Notary Public

My Commission Expires January 10, 1955.