


WELL PLUGGING RECORD

Give All Information Completely
Make Required Affidavit
Mail or Deliver Report to:
Conservation Division
State Corporation Commission
800 Biting Building
Wichita, Kansas

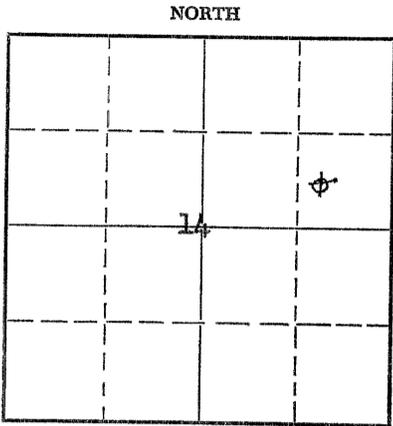

Locate well correctly on above Section Plat

Sedgwick County. Sec. 14 Twp. 27 S Rge. 2 (E) (W)
Location as "NE/CNW/SW" or footage from lines CW/2 SE NE
Lease Owner John P. Gaty
Lease Name Hoult Well No. 2
Office Address 11 Cypress Drive, Wichita, Kansas
Character of Well (completed as Oil, Gas or Dry Hole) Oil
Date well completed February 13, 19 54
Application for plugging filed April 24, 19 57
Application for plugging approved April 26, 19 57
Plugging commenced April 29, 19 57
Plugging completed May 8, 19 57
Reason for abandonment of well or producing formation Depleted

If a producing well is abandoned, date of last production April 19 57
Was permission obtained from the Conservation Division or its agents before plugging was commenced? Yes

Name of Conservation Agent who supervised plugging of this well Ruel Durkee
Producing formation _____ Depth to top _____ Bottom _____ Total Depth of Well 3235 Feet
Show depth and thickness of all water, oil and gas formations.

OIL, GAS OR WATER RECORDS

CASING RECORD

FORMATION	CONTENT	FROM	TO	SIZE	PUT IN	PULLED OUT

Describe in detail the manner in which the well was plugged, indicating where the mud fluid was placed and the method or methods used in introducing it into the hole. If cement or other plugs were used, state the character of same and depth placed, from _____ feet to _____ feet for each plug set.

Sand and gravel from 3235 to 3210
Six sacks cement at 3210
Mud to 175'
Rock bridge with 20 sacks cement at 175'
Mud to surface
Capped with 5 sacks cement.

RECEIVED
STATE CORPORATION COMMISSION
5-14-57
MAY 14 1957
CONSERVATION DIVISION
Wichita, Kansas

Name of Plugging Contractor John P. Gaty (If additional description is necessary, use BACK of this sheet)
Address 11 Cypress Dr., Wichita, Kansas

STATE OF Kansas, COUNTY OF Sedgwick, ss. Earl Wentworth

(employee of owner) or (owner or operator) of the above-described well, being first duly sworn on oath, says: That I have knowledge of the facts, statements, and matters herein contained and the log of the above-described well as filed and that the same are true and correct. So help me God.

(Signature) Earl Wentworth
734 Pippin Court, Wichita, Kansas
(Address)

SUBSCRIBED AND SWORN TO before me this 10th day of May, 19 57

My commission expires December 12, 1959

24-7368-S 3-53-20M

PLUGGING
FILE SEC 14 T. 27 R. 2E
BOOK PAGE 8 LINE 43

WELL LOG - Hoult #2

OPERATOR: Mr. J. P. Gaty
11 Cypress Drive
Forrest Hills
Wichita, Kansas

LOCATION: CWL SE/4 NE/4
Section 14-27S-2E
Sedgwick County, Kansas

CONTRACTOR: Morrison Drilling Company, Inc.
Drawer 712
El Dorado, Kansas

PRODUCTION: _____

Farm: Hoult Well #2

Date Commenced: February 3, 1954
Date Completed: February 13, 1954

Total Depth: 3223' - Rotary

From	To	Formation	CABLE TOOL LOG
40	80	Cement	
80	325	Lime & Shale	3221 1/2 (Cor. R.T.D.)-3228 Sand &
325	480	Lime & Shells	Shale
480	500	Lime & Shale	3228-3235 - Dolomite. Oil at
500	515	Red Bed	3233.
515	620	Lime & Shale	
620	1090	Shale & Shells	
1090	1325	Shale & Lime	
1325	1450	Shale	
1450	1880	Lime & Shale	
1880	2010	Shale & Lime Strks.	
2010	2215	Shale & Lime	
2215	2345	Lime	
2345	2385	Shale & Lime	
2385	2545	Lime	
2545	2653	Shale	
2653	2665	Lime & Shale	
2665	2740	Lime	
2740	2853	Lime & Shale	
2853	3112	Lime - Mississippi	
3112	3131	Lime & Shale	
3131	3181	Lime - Hunton	
3181	3189	Sand	
3189	3207	Shale	
3207	3223	Shale & Sand	
3223		Total Depth.	

RECEIVED
STATE CORPORATION COMMISSION

MAY 7 1957
CONSERVATION DIVISION
Wichita, Kansas

I hereby certify that the foregoing is a true and correct copy of the Well Log for the Hoult #2 well drilled for Mr. J. P. Gaty and completed February 13, 1954.

MORRISON DRILLING COMPANY, INC.

C. W. Wilson
C. W. Wilson - Secretary-Treasurer

STATE OF KANSAS)
COUNTY OF BUTLER) ss.

SUBSCRIBED AND SWORN TO, Before the Undersigned, a Notary Public, in and for the County and State aforesaid this 24th day of February, 1954.

STATE CORPORATION COMMISSION
APR 26 1957

Ann Dils
Notary Public

My Commission Expires January 10, 1955.

CONSERVATION DIVISION
Wichita, Kansas

PLUGGING
FILE SEC. 14 T 27 P 2E
BOOK PAGE 8 OF 43