


Give All Information Completely
File Required Affidavit
Mail or Deliver Report to:
Conservation Division
State Corporation Commission
800 Bitting Building
Wichita, Kansas

WELL PLUGGING RECORD

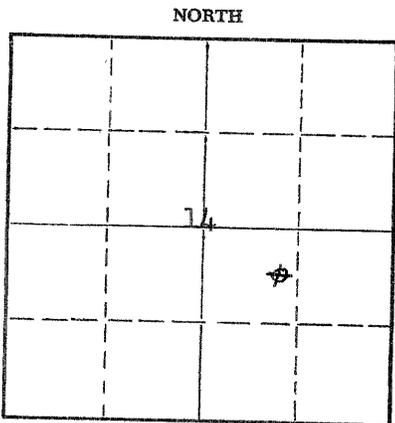

Locate well correctly on above
Section Plat

Sedgwick County. Sec. 14 Twp. 27S Rge. 2 (E) (W)
Location as "NE/CNW/SW" or footage from lines
Lease Owner John P. Gaty
Lease Name Hoult Well No. 7
Office Address 11 Cypress Drive, Wichita, Kansas
Character of Well (completed as Oil, Gas or Dry Hole) Dry
Date well completed June 19 19 54
Application for plugging filed June 21 19 54
Application for plugging approved June 21 19 54
Plugging commenced June 21 19 54
Plugging completed June 25 19 54
Reason for abandonment of well or producing formation Dry

If a producing well is abandoned, date of last production _____ 19____
Was permission obtained from the Conservation Division or its agents before plugging was commenced? Yes

Name of Conservation Agent who supervised plugging of this well Ruel Durkee
Producing formation Arbuckle Depth to top _____ Bottom _____ Total Depth of Well 3249 Feet
Show depth and thickness of all water, oil and gas formations.

OIL, GAS OR WATER RECORDS

CASING RECORD

FORMATION	CONTENT	FROM	TO	SIZE	PUT IN	PULLED OUT

Describe in detail the manner in which the well was plugged, indicating where the mud fluid was placed and the method or methods used in introducing it into the hole. If cement or other plugs were used, state the character of same and depth placed, from _____ feet to _____ feet for each plug set.



Plugged back from 3249' to 3235' with gravel
Dumped six sacks cement at 3235'
Mudded from 3235' to 190'
Set 20' rock bridge with 20 sacks cement at 190'
Mudded to 30' from top
Set rock bridge with 5 sacks cement to surface.

(If additional description is necessary, use BACK of this sheet)
Name of Plugging Contractor John P. Gaty
Address 11 Cypress Dr., Wichita, Kansas

STATE OF Kansas, COUNTY OF Sedgwick, ss.
Earl Wentworth (employee of owner) or (operator) of the above-described well, being first duly sworn on oath, says: That I have knowledge of the facts, statements, and matters herein contained and the log of the above-described well as filed and that the same are true and correct. So help me God.

(Signature) Earl Wentworth
734 Pippin Court, Wichita, Kansas
(Address)

SUBSCRIBED AND SWORN TO before me this 28th day of June, 19 54
My commission expires December 12, 1955
J. Arnold Howell Notary Public.

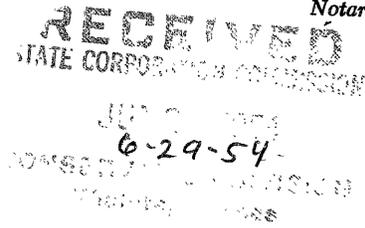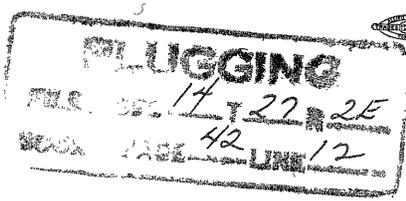

WELL LOG-HOULT #7

OPERATOR: Mr. J. P. Gaty
11 Cypress Drive, Forrest Hills
Wichita, Kansas

LOCATION: C/D/2 NW/4 SE/4
Section 14-27-2E
Sedgwick County, Kansas

CONTRACTOR: Morrison Drilling Company, Inc.
Drawer 712
El Dorado, Kansas

PRODUCTION: _____

Farm: Hoult Well #7
Date Commenced: 5-28-1954
Date Completed: 6-6-1954

Total Depth: 3245' - Rotary

CABLE TOOL LOG

<u>From</u>	<u>To</u>	<u>Formation</u>		
0	61	Cement		
61	180	Lime, Ruff	3245-3249	Dolomite.
180	440	Lime and shale streaks		Small show of oil.
440	1104	Lime and shale		Tight formation.
1104	1155	Lime		acidized with 6
1155	1600	Shale and lime		barrels of acid.
1600	2060	Lime and shale		swabbed 18 bbls
2060	2187	Shale and lime		fluid of which 2
2187	2390	Lime and shale		were oil (per hour).
2390	2516	Lime		Squeezed with diesel
2516	2781	Lime and shale		cement, 43 sacks at
2781	2848	Shale and lime		3600 pds/sq inch.
2848	2875	Mississippi Limestone & Chert		Shut off fluid.
2875	3017	Lime and chert		Plugged well.
3017	3093	Lime		
3093	3137	Shale		
3137	3152	Hurton		
3152	3172	Viols		
3172	3204	Simpson		
3204	3242	Sandy shale		
3242	3245	Arbuckle		
3245		Total Depth		

I hereby certify that the foregoing is a true and correct copy of the Well Log for the Hoult #7 well drilled for Mr. J. P. Gaty, and completed June 6, 1954.

MORRISON DRILLING COMPANY, INC.


C. W. Wilson - Secretary-Treasurer

STATE OF KANSAS)
) ss:
COUNTY OF BUTLER)

SUBSCRIBED AND SWORN TO, Before the Undersigned, a Notary Public, in and for County and State aforesaid this 8th day of June, 1954.


Notary Public

My Commission Expires January 10, 1955.

PLUGGING
FILE REC 14-27-2E
BOOK PAGE 42 LINE 12

CORP. SEC. 10-10-1954
MORRISON DRILLING COMPANY