


STATE OF KANSAS
STATE CORPORATION COMMISSION

Give All Information Completely
Make Required Affidavit
Mail or Deliver Report to:
Conservation Division
State Corporation Commission
211 No. Broadway
Wichita, Kansas

WELL PLUGGING RECORD

Sedgwick County. Sec. 14 Twp. 27 Rge. 2 (E) 1/4/1

Location as "NE/CNW/SW" or footage from lines. SE SW NE
Lease Owner Jimmy Razook
Lease Name Hoult Well No. 6
Office Address 1915 E. 21st, Wichita, Kansas
Character of Well (completed as Oil, Gas or Dry Hole) oil
Date well completed May 26, 19 54
Application for plugging filed Sept. 12, 19 62
Application for plugging approved Sept. 13, 19 62
Plugging commenced Sept. 16, 19 62
Plugging completed Sept. 19 11:00 A. M., 19 62
Reason for abandonment of well or producing formation low production

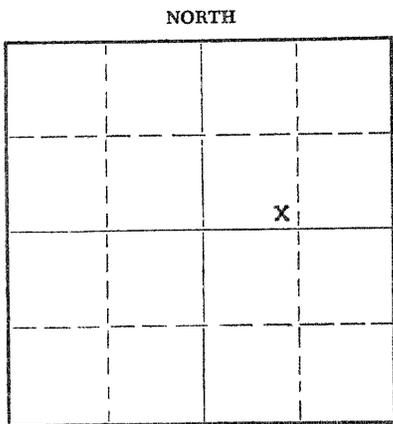

Locate well correctly on above
Section Plat

If a producing well is abandoned, date of last production _____ 19____
Was permission obtained from the Conservation Division or its agents before plugging was commenced? yes

Name of Conservation Agent who supervised plugging of this well Paul Turpin
Producing formation _____ Depth to top _____ Bottom _____ Total Depth of Well 3238 Feet
Show depth and thickness of all water, oil and gas formations.

OIL, GAS OR WATER RECORDS

CASING RECORD

FORMATION	CONTENT	FROM	TO	SIZE	PUT IN	PULLED OUT
				10 3/4	145	none
				7"	3238	1613.96

Describe in detail the manner in which the well was plugged, indicating where the mud fluid was placed and the method or methods used in introducing it into the hole. If cement or other plugs were used, state the character of same and depth placed, from _____ feet to _____ feet for each plug set.

Dumped 5 sacks cement with bailer at 3238 feet.
Bailed hole down to 175 feet, set 20 foot rock bridge
Dumped 20 sacks cement.
Mud hole to 30 feet, dumped 8 sacks cement.

RECEIVED
STATE CORPORATION COMMISSION
SEP 24 1962
9-24-62
CONSERVATION DIVISION

(If additional description is necessary, use BACK of this sheet)

Name of Plugging Contractor Kent Well Servicing Co., Inc.
Address Box 470, El Dorado, Kansas

STATE OF Kansas, COUNTY OF Butler, ss.
_____(employee of owner) or (owner or operator) of the above-described well, being first duly sworn on oath, says: That I have knowledge of the facts, statements, and matters herein contained and the log of the above-described well as filed and that the same are true and correct. So help me God.

(Signature) Mary Payne

(Address)

SUBSCRIBED AND SWORN TO before me this 21st day of September 21, 19 62

My commission expires April 14, 1966

Dale R. Daniel
Notary Public.



