


WELL PLUGGING RECORD

Give All Information Completely
Make Required Affidavit
Mail or Deliver Report to:
Conservation Division
State Corporation Commission
800 Biting Building
Wichita, Kansas

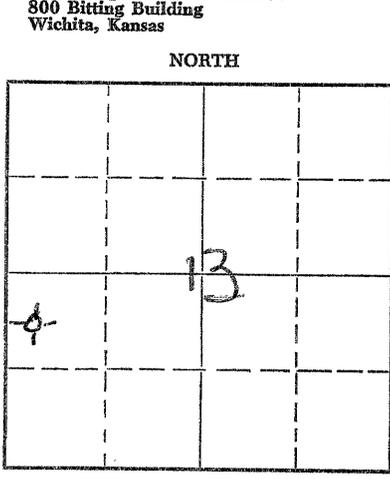

Locate well correctly on above Section Plat

Butler County. Sec. 13 Twp. 27S Rge. 2 (E) (W)
Location as "NE/CNW/SW" or footage from lines C/W 1/2 NW SW
Lease Owner J. P. Gaty
Lease Name Fischer Well No. 1
Office Address 11 Cypress Drive, Forrest Hills, Wichita, Kansas
Character of Well (completed as Oil, Gas or Dry Hole) Dry Hole
Date well completed April 7 19 54
Application for plugging filed Verbal April 8 19 54
Application for plugging approved Verbal April 8 19 54
Plugging commenced April 8 19 54
Plugging completed April 8 19 54
Reason for abandonment of well or producing formation

If a producing well is abandoned, date of last production 19
Was permission obtained from the Conservation Division or its agents before plugging was commenced? Yes

Name of Conservation Agent who supervised plugging of this well Ruel Durkee
Producing formation Depth to top Bottom Total Depth of Well 3306 Feet
Show depth and thickness of all water, oil and gas formations.

OIL, GAS OR WATER RECORDS

CASING RECORD

FORMATION	CONTENT	FROM	TO	SIZE	PUT IN	PULLED OUT

Describe in detail the manner in which the well was plugged, indicating where the mud fluid was placed and the method or methods used in introducing it into the hole. If cement or other plugs were used, state the character of same and depth placed, from feet to feet for each plug set.

Gummed up pits; filled hole w/heavy rotary mud to 160 ft. of top. Set solid bridge at 160 ft. and cemented w/25 sacks of cement. Filled hole on up to 10 ft. of base of cellar and capped w/5 sacks of cement.

4-14-54

Name of Plugging Contractor Morrison Drilling Company, Inc.
Address Drawer 712, El Dorado, Kansas

STATE OF Kansas COUNTY OF Sedgwick, ss.
John P. Gaty (employee of owner) or (owner or operator) of the above-described well, being first duly sworn on oath, says: That I have knowledge of the facts, statements, and matters herein contained and the log of the above-described well as filed and that the same are true and correct. So help me God.

(Signature) John P. Gaty
11 Cypress Dr., Wichita Kan.
(Address)

SUBSCRIBED AND SWORN TO before me this 14th day of April 19 54
J. Arnold Sewell
Notary Public.

My commission expires Dec. 12, 1955

PLUGGING
WELL SEC 13 T 27 R 2E
BOOK PAGE 26 LINE 32

WELL LOG - FISCHER #1

OPERATOR: Mr. J. P. Gaty
11 Cypress Drive
Forrest Hills
Wichita, Kansas

LOCATION: C/W $\frac{1}{2}$ NW/4 SW/4
Section 13-27S-2E
Sedgwick County, Kansas

CONTRACTOR: Morrison Drilling Company, Inc.
Drawer 712
El Dorado, Kansas

PRODUCTION: D + A

Farm: Fischer Well #1

Date Commenced: March 29, 1954

Date Completed: April 7, 1954

Total Depth: 3306' - Rotary

<u>From</u>	<u>To</u>	<u>Formation</u>
30	90	Cement
90	305	Lime and shells
305	650	Lime and shale
650	1125	Shale and lime streaks
1125	1140	Shale and lime
1140	1355	Lime and shale
1355	1538	Lime and shale streaks
1538	1760	Lime and shale
1760	1785	Lime
1785	2130	Lime and shale
2130	2170	Shale and lime
2170	2260	Lime
2260	2359	Lime w/shale breaks
2359	2379	Lime and shale
2379	2447	Lime
2447	2710	Lime and shale
2710	2751	Shale
2751	2835	Shale and lime
2835	2844	Shale and chert
2844	2989	Mississippi Lime
2989	3005	Lime
3005	3038	Lime - Mississippi
3038	3086	Lime
3086	3097	Shale and lime
3097	3167	Lime and shale
3167	3174	Lime and sandstone
3174	3189	Lime
3189	3202	Shale and lime streaks
3202	3227	Sandy shale
3227	3272	Shale and lime
3272	3306	Arbuckle
3306		Total Depth

I hereby certify that the foregoing is a true and correct copy of the Well Log for the Fischer #1 well drilled for Mr. J. P. Gaty and completed April 7, 1954.

MORRISON DRILLING COMPANY, INC.

C. W. Wilson
C. W. Wilson - Secretary-Treasurer

STATE OF KANSAS)
COUNTY OF BUTLER)

ss.

SUBSCRIBED AND SWORN TO before the Undersigned, a Notary Public, in and for the County and State aforesaid this 9th day of April, 1954.

Notary Public
Notary Public

My Commission expires January 10, 1955.

PLUGGING
FILE SEC 13 T 27 S 2E
BOOK PAGE 26 LINE 32

APR 10 1954
REGISTRATION DIVISION
Wichita, Kansas