




STATE OF KANSAS  
STATE CORPORATION COMMISSION

WELL PLUGGING RECORD

Give All Information Completely  
Make Required Affidavit  
Mail or Deliver Report to:  
Conservation Division  
State Corporation Commission  
211 No. Broadway  
Wichita, Kansas

Sedgwick County. Sec. 15 Twp. 27S Rge. 2 (E) E (W)

Location as "NE/CNW/SW" or footage from lines SE NW SE  
Lease Owner United Investments  
Lease Name Inness Innes ANG  
Office Address Plainview, Texas  
Character of Well (completed as Oil, Gas or Dry Hole) Dry Hole  
Date well completed 1-7-62 19  
Application for plugging filed 1-7-62 19  
Application for plugging approved 1-7-62 19  
Plugging commenced 1-7-62 19  
Plugging completed 1-7-62 19  
Reason for abandonment of well or producing formation Dry Hole

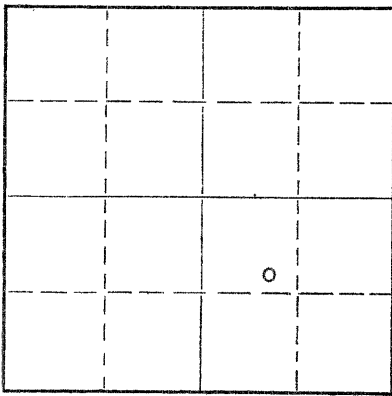

Locate well correctly on above  
Section Plat

If a producing well is abandoned, date of last production 19  
Was permission obtained from the Conservation Division or its agents before plugging was commenced? Yes

Name of Conservation Agent who supervised plugging of this well Lee Guthrie  
Producing formation none Depth to top Bottom Total Depth of Well 3325 Feet  
Show depth and thickness of all water, oil and gas formations.

OIL, GAS OR WATER RECORDS

CASING RECORD

FORMATION	CONTENT	FROM	TO	SIZE	PUT IN	PULLED OUT
		0	200	8 5/8	200	none

Describe in detail the manner in which the well was plugged, indicating where the mud fluid was placed and the method or methods used in introducing it into the hole. If cement or other plugs were used, state the character of same and depth placed, from feet to feet for each plug set.

Filled hole to 200' w/heavy drilling mud. Run Halliburton plug and 1/2 sack hulls to 200'. Dumped 20 sacks cement. Filled hole to 40' w/heavy drilling mud. Run Halliburton plug and 1/2 sack hulls to 40'. Dumped 8 sacks cement. Bridged rat hole w/2 sacks cement. Cut surface off 24" below ground level.

RECEIVED  
STATE CORPORATION COMMISSION  
JAN 17 1962  
1-17-62  
CONSERVATION DIVISION  
KANSAS

(If additional description is necessary, use BACK of this sheet)  
Name of Plugging Contractor Canaday Drilling Co.  
Address 6427 E. Kellogg Wichita, Kansas

STATE OF \_\_\_\_\_, COUNTY OF \_\_\_\_\_, ss.  
\_\_\_\_\_  
(employee of owner) or (owner or operator) of the above-described well, being first duly sworn on oath, says: That I have knowledge of the facts, statements, and matters herein contained and the log of the above-described well as filed and that the same are true and correct. So help me God.

(Signature) Ernest P. Canaday

SUBSCRIBED AND SWORN TO before me this 10th day of Jan 1962

My commission expires 9-15-62  
Ralph B. Carls Notary Public.



WELL LOG

COMPANY-United Investment

LEASE- Innes #1

LOCATION- SE NW SE

15-273-2E

Sedgwick County, Kansas

CONTRACTOR- Canaday Drilling Company

BASING- 200' of 8 5/8" surface-w/235 sacks cement

COMMENCED-12-22-61

COMPLETE- 1-7-62

TOTAL DEPTH- 3325'

**RECEIVED**  
STATE CORPORATION COMMISSION  
JAN 30 1962  
CONSERVATION DIVISION

FIGURES INDICATE BOTTOM OF FORMATION

40'	Gravel	2235'	Shale
200'	Lime	2622'	Lime
380'	Shale & shells	2702'	Lime & shale
745'	Shale & lime	2860'	Lime
1025'	Shale & shells	2897'	Lime & shale
1160'	Shale	3092'	Lime-cherty
1230'	Sand	3114'	Shale
1355'	Shale & lime	3192'	Shale and lime
1495'	Lime & shale	3218'	Lime
1632'	Shale & lime str.	3236'	Sand
1860'	Shale & lime	3255'	Shale
2000'	Lime	3325'	T. D.
2080'	Shale		
2125'	Lansing Lime		

I, G.E. Canaday, of Canaday Drilling Company, certify the above drilling log to be true and correct to the best of my knowledge

G.E. Canaday  
G.E. Canaday

Subscribed and sworn to before me, a notary public in and for Sedgwick County, Kansas, this 9th day of January, 1962.

Ralph E. Orlovick

My Commission expires 9-15-62