


WELL PLUGGING RECORD

Give All Information Completely  
Make Required Affidavit  
Mail or Deliver Report to:  
Conservation Division  
State Corporation Commission  
800 Bitting Building  
Wichita, Kansas

NORTH

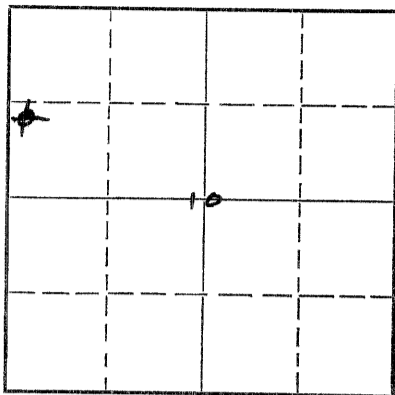

Locate well correctly on above  
Section Plat

Sedgwick County. Sec. 10 Twp. 28S Rge. 2 (E) (W)  
Location as "NE/CNW/SW" or footage from lines NW/4 SW/4 NW/4  
Lease Owner Mr. J. P. Gaty  
Lease Name Biermann Well No. 1  
Office Address 11 Cypress Drive, Forrest Hills, Wichita, Kansas.  
Character of Well (completed as Oil, Gas or Dry Hole) Dry Hole  
Date well completed April 15 19 54  
Application for plugging filed Verbal April 15 19 54  
Application for plugging approved Verbal April 15 19 54  
Plugging commenced April 15 19 54  
Plugging completed April 15 19 54  
Reason for abandonment of well or producing formation \_\_\_\_\_

If a producing well is abandoned, date of last production \_\_\_\_\_ 19 \_\_\_\_  
Was permission obtained from the Conservation Division or its agents before plugging was commenced? Yes

Name of Conservation Agent who supervised plugging of this well Mr. Durkee  
Producing formation \_\_\_\_\_ Depth to top \_\_\_\_\_ Bottom \_\_\_\_\_ Total Depth of Well 3330 Feet  
Show depth and thickness of all water, oil and gas formations.

OIL, GAS OR WATER RECORDS

CASING RECORD

FORMATION	CONTENT	FROM	TO	SIZE	PUT IN	PULLED OUT

Describe in detail the manner in which the well was plugged, indicating where the mud fluid was placed and the method or methods used in introducing it into the hole. If cement or other plugs were used, state the character of same and depth placed, from \_\_\_\_\_ feet to \_\_\_\_\_ feet for each plug set.

Filled hole up to 75 ft. of top W/Mud.  
Set Solid bridge cemented W/20 Sacks of  
Cement. Mixed and poured through Drill  
Pipe. Filled hole on up to 10 ft. of  
Base of Cellar W/Heavy Rotary Mud.  
Set Plug and Cap W/5 Sacks of Cement.

RECEIVED  
STATE CORPORATION COMMISSION  
4-27-54  
CONSERVATION DIVISION

(If additional description is necessary, use BACK of this sheet)  
Name of Plugging Contractor Morrison Drilling Company, Inc.  
Address Drawer 712, El Dorado, Kansas

STATE OF Kansas COUNTY OF Sedgwick, ss.  
John P. Gaty (employee of owner) or (owner or operator) of the above-described well, being first duly sworn on oath, says: That I have knowledge of the facts, statements, and matters herein contained and the log of the above-described well as filed and that the same are true and correct. So help me God.

(Signature) [Signature]  
11 Cypress Dr. Wichita Ks. (Address)

SUBSCRIBED AND SWORN TO before me this 22nd day of April, 19 54

My commission expires Dec. 12, 1955  
J. Donald Dowd Notary Public.

PLUGGING  
FILE SEC 10 28 2E  
BOOK PAGE 28 LINE 12

WELL LOG - BIERMANN #1

OPERATOR: Mr. J. P. Gaty  
11 Cypress Drive  
Forrest Hills  
Wichita, Kansas

LOCATION: NW/4 ~~SE~~ SW/4 NW/4  
Section 10-28S-2E  
Sedgwick County, Kansas

CONTRACTOR: Morrison Drilling Company, Inc.  
Drawer 712  
El Dorado, Kansas

Farm: Biermann Well #1

Date Commenced: April 9, 1954  
Date Completed: April 15, 1954

Total Depth: 3330 Feet - Rotary

<u>From</u>	<u>To</u>	<u>Formation</u>
70	280	Lime and shale streaks
280	300	Lime and shale
300	315	Red Bed
315	465	Lime and shale
465	500	Sandy lime
500	598	Lime and shale streaks
598	790	Shale and lime streaks
790	1760	Shale and lime
1760	1978	Lime and shale
1978	2505	Shale and lime
2505	2643	Lime
2643	2746	Shale and lime streaks
2746	2830	Shale and lime
2830	2874	Lime
2874	2980	Lime and shale
2980	2984	Red shale and rock
2984	3029	Mississippi lime
3029	3094	Lime
3094	3289	Lime and shale
3289	3315	Shale and lime
3315	3330	Simpson sand
3330		Total Depth

I hereby certify that the foregoing is a true and correct copy of the Well Log for the #1 Biermann well drilled for Mr. J. P. Gaty and completed April 15, 1954.

MORRISON DRILLING COMPANY, INC.

*C. W. Wilson*  
C. W. Wilson - Secretary-Treasurer

STATE OF KANSAS )  
COUNTY OF BUTLER ) ss.

SUBSCRIBED AND SWORN TO, Before the Undersigned, a Notary Public in and for the County and State aforesaid this 16th day of April, 1954.

*Ann Baker*  
NOTARY PUBLIC

My Commission Expires January 10, 1955.

**PLUGGING**  
PAGE 10 28 2E  
PAGE 28 12

RECEIVED  
GEOLOGICAL DIVISION  
Kansas