

15-173-00924-00-00

RECEIVED  
4-6-36  
6 1936

STATE OF KANSAS  
STATE CORPORATION COMMISSION

WELL PLUGGING RECORD

OR

FORMATION PLUGGING RECORD

Strike out upper line when reporting plugging of formations.

Give All Information Completely  
Make Required Affidavit  
Mail or Deliver Report to:  
Conservation Division  
State Corporation Commission,  
800 Bitting Building,  
Wichita, Kansas

Sedgwick County, Sec. 11, Twp. 28, Rge. 2 (E) ast (W)

Location as "NE 1/4 NW 1/4 SW 1/4" or footage from lines SW/4 SW/4 NW/4

Lease Owner T. C. Johnson

Lease Name Lula Jansen Well No. 1

Office Address Wichita, Kansas

Character of Well (Completed as Oil, Gas or Dry Hole) dry hole

Date, well completed April 3 1936

Application for plugging filed March 31 1936

Application for plugging approved March 31 1936


Plugging Commenced March 31 1936

Plugging Completed April 2 1936

Reason for abandonment of well or producing formation Dry

If a producing well is abandoned, date of last production 1936

Was permission obtained from the Conservation Division or its agents before plugging was commenced? Yes

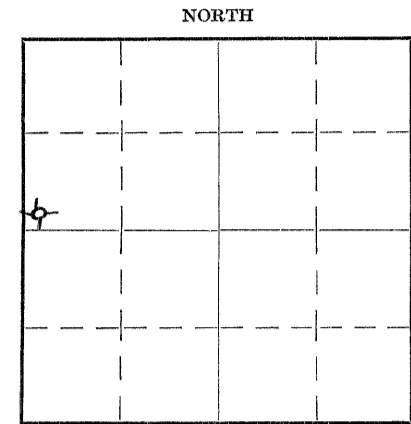

Locate well correctly on above Section Plat

Name of Conservation Agent who supervised plugging of this well Hal C. Smith

Producing formation None Depth to top Bottom Total Depth of Well 3404 Feet

Show depth and thickness of all water, oil and gas formations.

OIL, GAS OR WATER RECORDS

CASING RECORD

Formation	Content	From	To	Size	Put In	Pulled Out
gravel	2 BWPH	95'	97'	15 1/2"	120'	120'
gravel	10 BWPH	100'	115'	12 1/2"	738'	738'
sand	2 BWPH	710'	715'	10"	2148'	2148'
sand	HFV	715'	725'	8 1/4"	2975'	2975'
sand	1 1/2 BWPH	1125'	1130'			
lime	1 BW	1550'	1555'			
sandy lime	HFV	2590'	2610'			
chat	light show O & G	2975'	2980'			

Describe in detail the manner in which the well was plugged, indicating where the mud fluid was placed and the method or methods used in introducing it into the hole. If cement or other plugs were used, state the character of same and depth placed, from feet to feet for each plug set.

chat	trace oil	3021'	3028'			
chat	1/2 BWPH	3028'	3035'			
chat	small show oil	3035'	3040'			
Misner sand	water	3290'	3294'			
Siliceous Lime	2800' Water in hole		3404' T.D.			

11-28-36  
BOOK PAGE 40 LINE 7

Filled hole with mud from 3404' to 2975'. Pulled 8 1/4" casing. Filled with mud to 2148'. Pulled 10" casing and filled with mud to 738'. Pulled 12 1/2" casing. Bridged hole at 150' and put in 15' cement. Pulled 15 1/2" casing and filled hole to within 4' of bottom of cellar with mud, rock, etc. Cement plug 4' to bottom of cellar.

(If additional description is necessary use BACK of this sheet)

Correspondence regarding this well should be addressed to T. C. Johnson  
Address Wichita, Kansas.

STATE OF Kansas, COUNTY OF Sedgwick, ss.  
L. R. Pickrell

(employee of owner) ~~owner or operator~~ of the above-described well, being first duly sworn on oath, says: That I have knowledge of the facts, statements, and matters herein contained and the log of the above-described well as filed and that the same are true and correct. So help me God.

(Signature)

L. R. Pickrell  
705 Fourth National Bank Bldg.,  
Wichita, Kansas.

(Address)

SUBSCRIBED AND SWORN to before me this 4th day of April 1936.

My commission expires March 29, 1939.

M. M. Gowan  
Notary Public.


LOCATION: SW 1/4, Sec. 11, Twp. 28, R. 2 East,  
 Sedgwick County, Kansas.  
 FARM: Lula Jansen No. 1  
 COMPANY: T. C. Johnson  
 CONTRACTOR: Advance Drilling Company  
 COMMENCED: January 27, 1936.  
 COMPLETED: March 31, 1936.

Casing Record

15 1/2" 120  
 12 1/2" 738  
 10" 2140  
 8 1/2" 2705 U.R. 2975.

Cellar	10	lime	1025	shale	3855
yellow clay	40	shale	1125	lime	3860
clay	60	water sand 1 1/2 BWPH	1150	shale	3865
yellow clay	90	lime, hard	1157	shale & shells	3875
blue shale	95	slate	1200	lime	3880
gravel 2 BWPH	97	lime	1210	shale	3940
blue slate	100	shale	1225	lime	3950
gravel 10 BWPH	115	lime	1250	shale	3955
blue slate	120	slate	1255	red rock	3975
lime	132	lime	1310	chat	3980
blue slate	140	shale	1350	light show oil & gas 2975-80	
lime	160	lime	1340	chat	3050
shale, light	170	shale	1410	trace oil 3021-25	
lime, hard	178	lime	1460	1/2 BWPH 3025-35	
lime, broken	190	slate	1475	small show oil 3035-40	
shale	195	lime	1492	lime & chat	3080
lime	215	shale	1545	lime	3165
shale, blue	220	lime 1 BW 1550-55	1590	shale	3170
lime	270	slate	1630	lime	3180
slate & shells	285	lime	1660	shale, green	3200
blue slate	290	shale	1665	lime	3222
lime	295	lime	1670	black shale	3290
red rock	325	shale	1685	reduced hole to 8" at 5270'	
lime, hard	360	lime	1695	Misner sand (water)	3294
lime, broken	370	shale	1745	Viola cherty lime	3305
lime	395	lime	1752	Wilcox sand	3355
blue shale	398	shale & shells	1760	sand & green shale	3370
shale & shells	405	lime, hard	1770	siliceous lime	3405 T.D.
lime	475	shale	1775	3405 equals 3404 Cable Correction	
shale	485	lime	1800		
red rock	490	shale	1805		
lime	500	lime	1820		
shale	510	shale	1840		
lime	530	lime	1880		
blue slate	535	shale	1895		
lime	550	lime	1932		
red rock	585	shale	1940		
lime	600	shale & shells	1950		
shale	605	lime	1971		
lime	630	shale	1980		
shale	650	lime	1984		
lime	690	shale	1990		
slate & shells	700	lime	2000		
lime	710	shale	2140		
sand	735	lime	2150		
2 BWPH 710-15		shale	2180		
BWPH 715-25		lime	2225		
blue slate	740	sandy lime soft	2245		
lime	748	shale	2320		
red rock	750	lime	2350		
shale	755	shale	2350		
lime	765	Kansas City Lime	2590		
white slate	775	sandy lime	2610		
lime	780	BWPH 2590-2610			
shale & shells	800	lime	2655		
shale	825	shale	2697		
lime	845	lime	2717		
shale	855	shale	2725		
lime, broken	860	shale black	2740		
lime	865	shale, gray	2750		
shale	880	lime	2755		
lime	890	shale	2785		
shale	900	lime	2800		
lime	920	shale	2810		
slate	955	lime	2815		
lime	960	shale	2830		
slate	1010	lime	2850		

NO SHOWS OF OIL BELOW  
 CHAT. HAD 2800 FT. OF  
 WATER IN HOLE AT 3404'  
 T.D. DRY & ABANDONED.

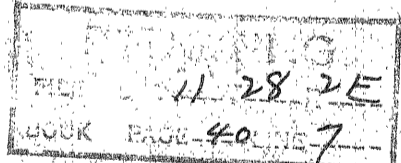

STATE OF KANSAS

COURT OF SEDGWICK

} SS.

I, R. A. Whorton, of lawful age, being first duly sworn under oath, state that I am familiar with the log of the Lule Jansen No. 1 drilled in the SWe of the NW $\frac{1}{4}$  of Section 11, Township 28, Range 2 East, Sedgwick County, Kansas, and that this is a true and correct copy of said log.

R. A. Whorton

Subscribed and sworn to before me this 7<sup>th</sup> day of April A. D., 1936.

J. M. Lusk

Notary Public

My Commission Expires: March 29-1939