


# WELL RECORD

15-173-00798-00-00

WELL NO. **2** LEASE **Rose Hamant** COMPANY **Gypsy Oil Company** AUTH. **K-1191**  
 DATE—Drilling Began **5-4-29** Well Completed **6-7-29** First Production **6-7-29**  
 SHOT—Date **None** With \_\_\_\_\_ Quarts—From \_\_\_\_\_ To \_\_\_\_\_ By \_\_\_\_\_  
 SAND RECORD **Sand 3234' to 3237'** TOTAL DEPTH **3237'**  
 INITIAL PRODUCTION\* **"S" 1335.00 Bbls. 6-8-29**

### CASING RECORD

Size	Wt.	Thd.	Class	Make	Run	Sacks Cement	Pounds Cal. Chlo.	Pulled	Left In
12 1/2	50	8	SH	Lanweld	110	250	300		110
8 1/2	32	10	New	Seamless	3117	500	700		3117
6 5/8	24	10	New	Seamless	3226				3226

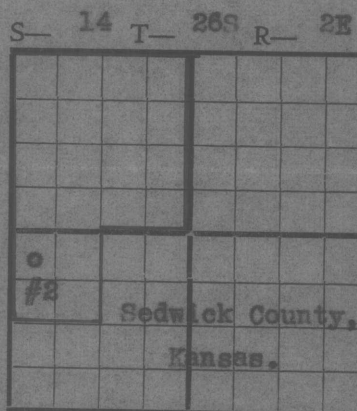

ELEVATION 1400'

(\*) Best Day; "F", Flowing Naturally; "L", Air-Gas Lift; "S", Swabbing; "P", Pumping.

**RECEIVED**  
 Conservation Div.  
 AUG 30 1950  
 STATE CORPORATION  
 COMMISSION  
 KANSAS

**PLUGGING**  
 FILE SEC-14 T-26S R-2E  
 BOOK PAGE 74 LINE 30

#2

WELL LOG RECORD


DATE—Drilling began  
 SHOT—Date  
 SAND RECORD  
 INITIAL PRODUCTION

Well Comp. 111  
 150  
 200  
 275  
 405  
 405  
 600  
 700  
 800  
 1521

Shale and sand shells  
 Lime  
 Bkn lime  
 Shale, lime shells  
 Shale  
 Bkn lime  
 Shale, lime shells  
 Sandy shale  
 Shale - Shells


Stratum	Feet	Feet	Grain	Class	WC	Tab	Sec
Sand, lime shells	1521	1520					
Shale	1520	1600					
Lime	1600	1620					
Shale - Shells	1620	1900					
Shale, slate	1900	2000					
Shale, bkn lime	2000	2245					
Shale	2245	2325					
Lime - shale	2325	2360					
Lime	2360	2380					
Shale, lime shells	2380	2685					
Lime	2685	2710					
Shale	2710	2940					
Sandy lime	2940	2985					
Shale	2985	2985					
Lime	2985	2950					
Shale	2950	2955					
Lime	2955	2965					
Chat - lime	2965	3020					
Lime	3020	3035					
Lime - some shale	3035	3065					
Lime	3065	3182					
Shale	3182	3200					
Slate	3200	3234					
Sand	3234	3237					
TOTAL DEPTH		3237					

