


STATE OF KANSAS
STATE CORPORATION COMMISSION

Give All Information Completely
Make Required Affidavit
Mail or Deliver Report to:
Conservation Division
State Corporation Commission
211 No. Broadway
Wichita, Kansas

WELL PLUGGING RECORD

NORTH

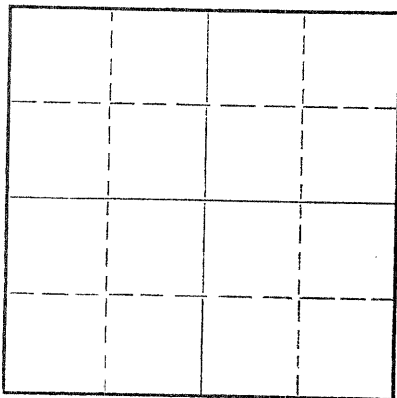

Locate well correctly on above
Section Plat

Graham County. Sec. 29 Twp. 8S Rge. 22W (E) (W)
Location as "NE/CNW/SW" or footage from lines SE SE SW
Lease Owner Aurora Gasoline Company
Lease Name Dreiling Well No. 2
Office Address 425 Wright Bldg. Tulsa, Okla.
Character of Well (completed as Oil, Gas or Dry Hole) Dry Hole
Date well completed 8-30-58
Application for plugging filed 8-30-58 19
Application for plugging approved 8-30-58 19
Plugging commenced 8-30-58 19
Plugging completed 8-30-58 19
Reason for abandonment of well or producing formation dry hole

If a producing well is abandoned, date of last production _____ 19____
Was permission obtained from the Conservation Division or its agents before plugging was com-
menced? Yes

Name of Conservation Agent who supervised plugging of this well A. B. Fabricus, Hill City, Kansas
Producing formation _____ Depth to top _____ Bottom _____ Total Depth of Well 3700 Feet
Show depth and thickness of all water, oil and gas formations.

OIL, GAS OR WATER RECORDS

CASING RECORD

FORMATION	CONTENT	FROM	TO	SIZE	PUT IN	PULLED OUT
				8 5/8"	215' w/140 sacks	

Describe in detail the manner in which the well was plugged, indicating where the mud fluid was placed and the method or methods used in introducing it into the hole. If cement or other plugs were used, state the character of same and depth placed, from _____ feet to _____ feet for each plug set.

1st plug set at 550' with 1/2 sack hulls, 25 sacks cement; second plug at 210' with 1/2 sack hulls, 15 sacks cement; third plug at 40' with 1/2 sack hulls, 10 sacks cement.

RECEIVED
STATE CORPORATION COMMISSION

SEP 11 1958
SEP 11 1958
CONSERVATION DIVISION

Name of Plugging Contractor Veeder Supply and Development Co.
Address Box 201, Cherryvale, Kansas

STATE OF Kansas, COUNTY OF Montgomery, ss.
G. H. Woods, (employee of owner) or (owner/operator) of the above-described well, being first duly sworn on oath, says: That I have knowledge of the facts, statements, and matters herein contained and the log of the above-described well as filed and that the same are true and correct. So help me God.

(Signature) G. H. Woods
Cherryvale, Kansas
(Address)


SUBSCRIBED AND SWORN TO before me this 3rd day of September, 1958

My commission expires July 11, 1958

Lois Lawson
Notary Public.

PLUGGING
FILE SEC 29 T 8 R 22W
BOOK PAGE 129 LINE 1

Veeder Supply & Dev'l. Co.

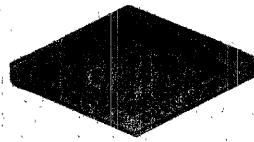

Cherryvale, Kansas

Drilled for Aurora Gasoline Company Farm Dreiling No. 2 Depth 3700'
Veeder Supply & Development Co.
 Contractor Veeder Supply & Development Co. Pipe 215' 8 5/8" csg. w/140 sacks
 Location SE/4 SE/4 SW/4 Sec. 29 Twp. 8S Range 22W
 Commenced 8-21-58 Completed 8-30-58 County Graham State Kansas

Cellar	0	9	9
Soil	9	40	31
Sand shale	40	55	15
Shale	55	215	160
Shale and shells	215	975	760
Sand shale	975	1235	260
Shells, shale	1235	1340	105
Sand, shale	1340	1560	220
Shale, shells, red bed	1560	1800	240
Anhydrite	1800	1835	35
Shale and shells	1835	2440	605
Lime and shale	2440	2560	120
Lime	2560	2760	200
Lime and shale	2760	3155	395
Lime	3155	3700	545
T. D.	3700'		

Elevation: 2221 DF
2219 Gr.

Tops:	Heebner	3446
	Kansas City	3484
	Toronto	3467
	Lansing	3484

AFFIDAVIT

STATE OF KANSAS)
Montgomery County) SS

C. H. Woods, of lawful age, being first duly sworn on oath, deposes and says:

That he has read the above drilling log covering the Dreiling #2 well located in Section 29-8S-22W. Graham County, Kansas, and that the same is true and correct. Further affiant saith not.

THE VEEDER SUPPLY & DEVELOPMENT CO.

By C. H. Woods
C. H. Woods

Subscribed and sworn to before me this 3rd day of September, 1958.

Lola Lawson
Notary Public

My Commission Expires July 11, 1960.

RECEIVED
CORPORATION COMMISSION
SEP 11 1958

PLUGGING
FILE SEC 29 T 8 R 22W
BOOK PAGE 129 LINE 1