


STATE OF KANSAS  
STATE CORPORATION COMMISSION

WELL PLUGGING RECORD

Give All Information Completely  
Make Required Affidavit  
Mail or Deliver Report to  
Conservation Division  
State Corporation Comm.  
245 North Water  
Wichita, KS 67202

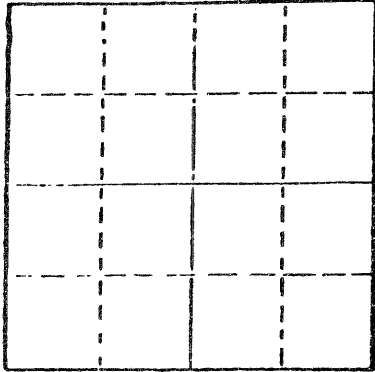

Locate well correctly on above  
Section Plat

Graham County, Sec. 29 Twp. 8S Rge. 22W 18/W  
Location as "NE/CNW 1/4 SW 1/4" or footage from lines  
850' FNL & 1320' FEL of NE/4  
Lease Owner Graham-Michaelis Corporation  
Lease Name Moore Well No. 1-29  
Office Address 211 North Broadway, Wichita, Kansas 67202  
Character of Well (Completed as Oil, Gas or Dry Hole) D & A  
Date Well completed December 13, 1978  
Application for plugging filed December 13, 1978  
Application for plugging approved December 13, 1978  
Plugging commenced December 13, 1978  
Plugging completed December 13, 1978  
Reason for abandonment of well or producing formation D & A

If a producing well is abandoned, date of last production 19

Was permission obtained from the Conservation Division or its agents before plugging was commenced? Yes

Name of Conservation Agent who supervised plugging of this well Gil Balthazor  
Producing formation \_\_\_\_\_ Depth to top \_\_\_\_\_ Bottom \_\_\_\_\_ Total Depth of Well 3,848'  
Show depth and thickness of all water, oil and gas formations.

OIL, GAS OR WATER RECORDS

CASING RECORD

FORMATION	CONTENT	FROM	TO	SIZE	PUT IN	PULLED OUT
				8 5/8"	200'	-0-

Describe in detail the manner in which the well was plugged, indicating where the mud fluid was placed and the method or methods used in introducing it into the hold. If cement or other plugs were used, state the character of same and depth placed, from \_\_\_\_\_ feet to \_\_\_\_\_ feet for each plug set.

Plug #1 @ 800' w/70 sx cement  
Plug #2 @ 185' w/20 sx cement  
Plug #3 @ 40' w/10 sx cement  
50-50 Pozmix, 6% Gel

RECEIVED  
STATE CORPORATION COMMISSION

DEC 21 1978

12-21-78

CONSERVATION DIVISION  
WICHITA, KANSAS

(If additional description is necessary, use BACK of this sheet)

Name of Plugging Contractor Red Tiger Drilling Company  
1720 KSB&T Building, Wichita, Kansas 67202

STATE OF Kansas COUNTY OF Sedgwick, ss. contractor  
Gloria Fawcett (employee of ~~xxxxxx~~)


of the above-described well, being first duly sworn on oath, says: That I have knowledge of the facts, statements, and matters herein contained and the log of the above-described well as filed and that the same are true and correct. So help me God.

(Signature) Gloria Fawcett  
1720 KSB&T Building, Wichita, Kansas 67202  
(Address)

SUBSCRIBED AND SWORN TO before me this 18th day of December, 1978.

My commission expires \_\_\_\_\_

Joyce A. Hagermann  
Notary Public.

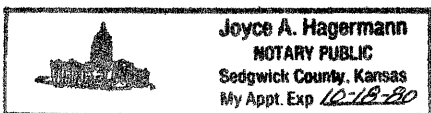

DRILLERS LOG

No. 1-29 Moore

CASING RECORD: 8 5/8" @ 208' w/160 sx cement	COMPANY: Graham-Michaelis Corporation	DESCRIPTION: 850' FNL & 1320' FEL of NE/4 Sec. 29-T8S-R22W Graham County, Kansas
	CONTRACTOR: Red Tiger Drilling Company	
	COMMENCED: December 4, 1978	
	COMPLETED: December 13, 1978	
TOTAL DEPTH: 3,848'		ELEVATION: 2,194' KB

<u>FORMATION</u>	<u>FROM</u>	<u>TO</u>	<u>REMARKS</u>
Shale	0	1310	
Sand	1310	1515	
Shale & Red Bed	1515	1779	
Anhydrite	1779	1815	
Shale & Red Bed	1815	2025	
Shale	2025	2735	
Shale & Lime Streaks	2735	2905	
Lime	2905	3848	
RTD		3848	

I certify that this is a true and correct copy of the above log to the best of my knowledge.

RED TIGER DRILLING COMPANY

Gloria Fawcett  
Gloria Fawcett

Subscribed and sworn to before me this 18th day of December, 1978.

Joyce A. Hagermann  
Notary Public



RECEIVED  
STATE CORPORATION COMMISSION  
DEC 22 1978  
12-22-1978  
CONSERVATION DIVISION  
Wichita, Kansas