


STATE OF KANSAS
STATE CORPORATION COMMISSION

Give All Information Completely
Make Required Affidavit
Mail or Deliver Report to:
Conservation Division
State Corporation Commission
212 North Market, Insurance Bldg.
Wichita, Kansas

15-065-20639-00-00

WELL PLUGGING RECORD

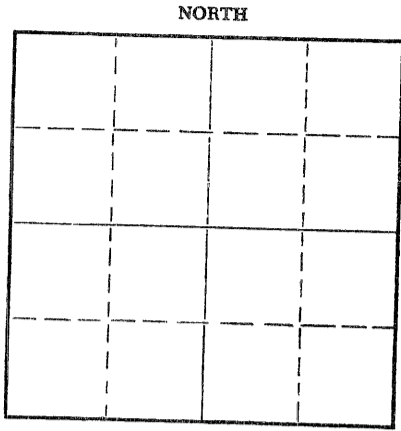

Locate well correctly on above Section Plat

Graham

County. Sec. 32 Twp. 8 Rge. 22W (E) (W)

Location as "NE/CNW/SW" or footage from lines NW NW SE

Lease Owner F & M Oil Company

Lease Name Hull

Office Address 603 Union Center, Wichita, Kansas 6720 Well No. 1

Character of Well (completed as Oil, Gas or Dry Hole) Dry hole

Date well completed _____ 19__

Application for plugging filed _____ 19__

Application for plugging approved _____ 19__

Plugging commenced _____ 19__

Plugging completed 11:45 A.M., December 8 19 73

Reason for abandonment of well or producing formation _____

If a producing well is abandoned, date of last production _____ 19__

Was permission obtained from the Conservation Division or its agents before plugging was commenced? yes

Name of Conservation Agent who supervised plugging of this well W. L. Nichols, Morland, Kansas

Producing formation _____ Depth to top _____ Bottom _____ Total Depth of Well 3870 Feet

Show depth and thickness of all water, oil and gas formations.

OIL, GAS OR WATER RECORDS

CASING RECORD

FORMATION	CONTENT	FROM	TO	SIZE	PUT IN	PULLED OUT

Describe in detail the manner in which the well was plugged, indicating where the mud fluid was placed and the method or methods used in introducing it into the hole. If cement or other plugs were used, state the character of same and depth placed, from _____ feet to _____ feet for each plug set.

Plug #1 975' 110 cu. ft.

Plug #2 215' 30 cu. ft.

Plug #3 40' 10 cu. ft.

RECEIVED
STATE CORPORATION COMMISSION
DEC 18 1973
12-18-1973
CONSERVATION DIVISION
Wichita, Kansas

Name of Plugging Contractor John O. Farmer, Inc. (If additional description is necessary, use BACK of this sheet)
Address Box 352, Russell, Kansas 67665

STATE OF Kansas, COUNTY OF Russell, ss. John O. Farmer

well, being first duly sworn on oath, says: That I have knowledge of the facts, statements, and matters herein contained and the log of the above-described well as filed and that the same are true and correct. So help me God.


(Signature) John O. Farmer President

Box 352, Russell, Kansas 67665 (Address)

Subscribed AND Sworn to before me this 12th day of December, 19 73

My commission expires February 15, 1975

Helen Carlson Notary Public.

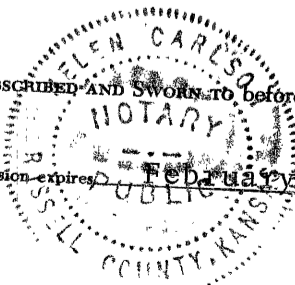

15-065-20639-00-00

DRILLERS LOG

HULL #1

CASING RECORD: OPERATOR: F. & M. Oil Company DESCRIPTION:
211' 8-5/8" CONTRACTOR: John O. Farmer, Inc. NW NW SE
w/150 sx cement COMMENCED: November 27, 1973 Sec. 32-8-22W
TOTAL DEPTH: GRAHAM COUNTY, Ks.
3870' COMPLETED: December 8, 1973

<u>FORMATION</u>	<u>FROM</u>	<u>TO</u>
Shale	0	211
Shale & Shells	211	1210
Shale & Sand	1210	1330
Sand	1330	1525
Red bed	1525	1800
Anhydrite	1800	1833
Shale & Shells	1833	2495
Shale & Lime	2495	2610
Lime & Shale	2610	2875
Shale & Lime Streaks	2875	2985
Lime & Shale	2985	3407
Lime	3407	3760
Lime, Shale & Chert	3760	3855
Arbuckle	3855	3870

RECEIVED
STATE CORPORATION COMMISSION
DEC 18 1973
CONSERVATION DIVISION
Wichita, Kansas

I certify that this is a true and correct copy of the above log to the best of my knowledge.

JOHN O. FARMER, INC.

John O. Farmer
John O. Farmer

Subscribed and sworn to before me this 12th day of December, 1973.

Helen Carlson
Helen Carlson

My commission expires:
February 15, 1975

