

CARD MUST BE TYPED

# NOTICE OF INTENTION TO DRILL

(see rules on reverse side)

State of Kansas  
Ex. tended to: 8-23-85  
2-4-85 CARD MUST BE SIGNED

Starting Date: ... September ... 1 ... 1984 ...  
month day year

API Number 15- 065-22,054-00  
SESESE Sec 14 Twp 8 S, Rge 22  East  West

OPERATOR: License # 6278  
Name PETX Petroleum Corporation  
Address 1616 Glenarm Place #1700  
City/State/Zip Denver, CO 80202  
Contact Person Robert E. Johnson  
Phone (303) 629-1098

330 Ft North from Southeast Corner of Section  
330 Ft West from Southeast Corner of Section  
(Note: Locate well on Section Plat on reverse side)

CONTRACTOR: License # ~~51107~~ 6533  
Name H-30 Inc. Martin Dely  
City/State Wichita, Kansas

Nearest lease or unit boundary line 330 feet.  
County Graham  
Lease Name Faulkner Well # 1

Well Drilled For: Well Class: Type Equipment:  
 Oil  Swd  Infield  Mud Rotary  
 Gas  Inj  Pool Ext.  Air Rotary  
 OWWO  Expl  Wildcat  Cable

Domestic well within 330 feet:  yes  no  
Municipal well within one mile:  yes  no

If OWWO: old well info as follows:

Operator .....  
Well Name .....  
Comp Date ..... Old Total Depth .....  
Projected Total Depth 3800 feet  
Projected Formation at TD Arbuckle  
Expected Producing Formations Lansing, Arbuckle

Depth to Bottom of fresh water 500 feet  
Lowest usable water formation Dakota  
Depth to Bottom of usable water 600 1025 feet  
Surface pipe by Alternate: 1  2   
Surface pipe to be set 300 feet  
Conductor pipe if any required ..... feet  
Ground surface elevation 2118 feet MSI  
This Authorization Expires ~~2-23-85~~ 8-23-85  
Approved By E. J. J. R.

I certify that we will comply with K.S.A. 55-101, et seq., plus eventually plugging hole to K.C.C. specifications.

Date 8/20/84 Signature of Operator or Agent

R. A. Huck

Title Vice President / Exploration


Form C-1 4/84

MHC / NONE 8/23/84

Must be filed with the K.C.C. five (5) days prior to commencing well  
 This card void if drilling not started within six (6) months of date received by K.C.C.

**Important procedures to follow:**

**A Regular Section of Land  
 1 Mile = 5,280 Ft.**

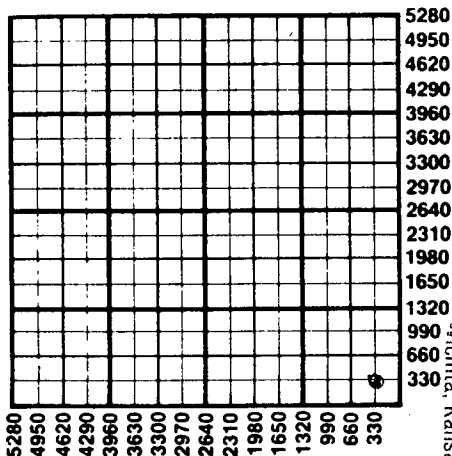

ACTIVATION DIVISION  
 Wichita, Kansas

AUG 23 1984

RECEIVED  
 CORPORATION COMMISSION

1. Notify District office before setting surface casing.
2. Set surface casing by circulating cement to the top.
3. File completion forms ACO-1 with K.C.C. within 90 days of well completion, following instructions on ACO-1, side 1, and including copies of wireline logs.
4. Notify District office 48 hours prior to old well workover or re-entry.
5. Prior to plugging, prepare a plugging plan, then obtain agreement from the appropriate district office for an approved plugging plan.
6. Submit plugging report (CP-4) to K.C.C. after plugging is completed.
7. Obtain an approved injection docket number before disposing of salt water.
8. Notify K.C.C. within 10 days when injection commences or terminates.
9. If an alternate 2 completion, cement in the production pipe from below a sealable water to surface within 120 days of spud date.

State Corporation Commission of Kansas  
 Conservation Division  
 200 Colorado Derby Building  
 Wichita, Kansas 67202  
 (316) 263-3238

8-23-84