

CARD MUST BE TYPED

State of Kansas  
**NOTICE OF INTENTION TO DRILL**  
(see rules on reverse side)

CARD MUST BE SIGNED

Starting Date: October 10, 1984  
month day year 4-45

API Number 15- 173-20,675-00-00

**OPERATOR:** License # 5188  
Name SILVER CREEK OIL & GAS, INC.  
Address 1900 No. Amidon, Ste. 221  
City/State/Zip Wichita, Kansas 67203  
Contact Person Gregory B. Porterfield  
Phone (316) 832-0603

Approx. (NE) SW NE. Sec (45) Twp 27 S, Rge 2 ...  East  West  
(location)

3630 Ft North from Southeast Corner of Section  
1650 Ft West from Southeast Corner of Section  
(Note: Locate well on Section Plat on reverse side)

**CONTRACTOR:** License # 5107  
Name H-30 Drilling  
City/State Wichita, Kansas

Nearest lease or unit boundary line 660 feet.  
County Sedgwick

Lease Name H.C. Development Well# Hart #1

Domestic well within 330 feet:  yes  no

Municipal well within one mile:  yes  no

**Well Drilled For:** **Well Class:** **Type Equipment:**  
 Oil  Swd  Infield  Mud Rotary  
 Gas  Inj  Pool Ext.  Air Rotary  
 OWWO  Expl  Wildcat  Cable

Depth to Bottom of fresh water ..... feet

Lowest usable water formation ..... feet

Depth to Bottom of usable water 200 ..... feet


Surface pipe by Alternate: 1  2

Surface pipe to be set 200 ..... feet

Conductor pipe if any required ..... feet

Ground surface elevation ..... feet MSL

This Authorization Expires 4-9-85

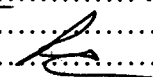Approved By 10-9-84 

I certify that we will comply with K.S.A. 55-101, et seq., plus eventually plugging hole to K.C. specifications.

Date October 4, 1984  
Signature of Operator or Agent 

Title Secretary

Must be filed with the K.C.C. five (5) days prior to commencing well

This card void if drilling not started within six (6) months of date received by K.C.C.

RECEIVED


STATE CORPORATION COMMISSION

OCT 9 1984

10-9-84

A Regular Section of Land

1 Mile = 640 Acres

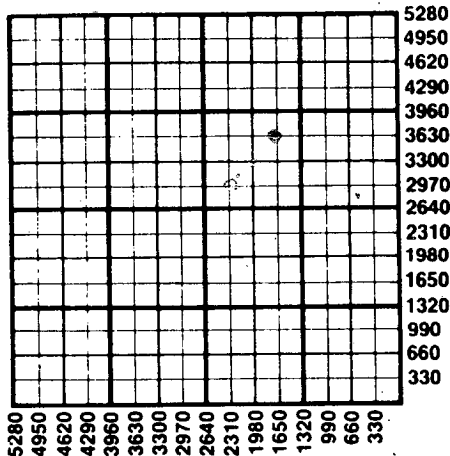

**Important procedures to follow :**

1. Notify District office before setting surface casing.
2. Set surface casing by circulating cement to the top.
3. File completion forms ACO-1 with K.C.C. within 90 days of well completion, following instructions on ACO-1, side 1, and including copies of wireline logs.
4. Notify District office 48 hours prior to old well workover or re-entry.
5. Prior to plugging, prepare a plugging plan, then obtain agreement from the appropriate district office for an approved plugging plan.
6. Submit plugging report (CP-4) to K.C.C. after plugging is completed.
7. Obtain an approved injection docket number before disposing of salt water.
8. Notify K.C.C. within 10 days when injection commences or terminates.
9. If an alternate 2 completion, cement in the production pipe from below any usable water to surface within 120 days of spud date.

State Corporation Commission of Kansas  
 Conservation Division  
 200 Colorado Derby Building  
 Wichita, Kansas 67202  
 (316) 263-3238