

CARD MUST BE TYPED

State of Kansas
NOTICE OF INTENTION TO DRILL

CARD MUST BE SIGNED

(see rules on reverse side)

Starting Date: November.....10.....1985.....
month day year

API Number 15- 065-22,265-00-00

OPERATOR: License # ...9067.....
Name DaMar Resources, Inc.....
Address 217 East 32nd Suite A Box 70.....
City/State/Zip Hays, Kansas 67601.....
Contact Person Daniel F. Schippers.....
Phone (913) 625-0020.....

100' SW. NE. SW. NW Sec. 30. Twp. 10. S, Rge. 21. East
(location) West

3560..... Ft North from Southeast Corner of Section
4360..... Ft West from Southeast Corner of Section
(Note: Locate well on Section Plat on reverse side)

CONTRACTOR: License # ...4087.....
Name Williamson Drilling, Inc.....
City/State Great Bend, Kansas.....

Nearest lease or unit boundary line 920..... feet.
County Graham.....
Lease Name Grecian..... Well# 1.....

Domestic well within 330 feet: yes no
Municipal well within one mile: yes no

Well Drilled For: Well Class: Type Equipment:
 Oil Swd Infield Mud Rotary
 Gas Inj Pool Ext. Air Rotary
 OWWO Expl Wildcat Cable

Depth to Bottom of fresh water 150 305..... feet
Lowest usable water formation Dakota.....
Depth to Bottom of usable water 650 700..... feet
Surface pipe by Alternate: 1 2
Surface pipe to be set 200 325..... feet
Conductor pipe if any required N/A..... feet
Ground surface elevation 21.92..... feet MSI.
This Authorization Expires 5-1-86.....
Approved By 10-31-85..... *R.E.*

If OWWO: old well info as follows:
Operator
Well Name
Comp Date Old Total Depth
Projected Total Depth 3900..... feet
Projected Formation at TD Arbuttle.....
Expected Producing Formations Lansing.....


I certify that we will comply with K.S.A. 55-101, et seq., plus eventually plugging hole to K.C.C. specifications.

Date 10/30/85..... Signature of Operator or Agent *Gene Johnson* Title President.....
Form C-1 4/84

Must be filed with the K.C.C. five (5) days prior to commencing well
This card void if drilling not started within six (6) months of date received by K.C.C.

Important procedures to follow :

**A Regular Section of Land
1 Mile = 5,280 Ft.**

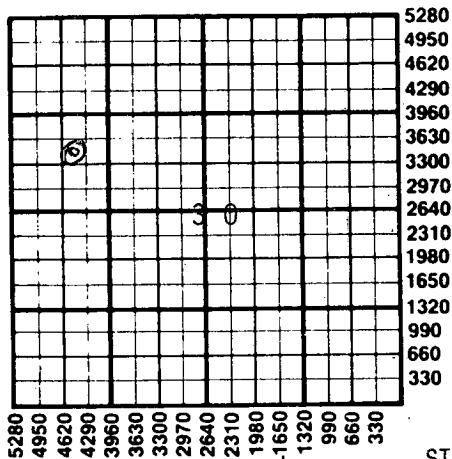

1. Notify District office before setting surface casing.
2. Set surface casing by circulating cement to the top.
3. File completion forms ACO-1 with K.C.C. within 90 days of well completion, following instructions on ACO-1, side 1, and including copies of wireline logs.
4. Notify District office 48 hours prior to old well workover or re-entry.
5. Prior to plugging, prepare a plugging plan, then obtain agreement from the appropriate district office for an approved plugging plan.
6. Submit plugging report (CP-4) to K.C.C. after plugging is completed.
7. Obtain an approved injection docket number before disposing of salt water.
8. Notify K.C.C. within 10 days when injection commences or terminates.
9. If an alternate 2 completion, cement in the production pipe from below any usable water to surface within 120 days of spud date.

RECEIVED
STATE CORPORATION COMMISSION

State Corporation Commission of Kansas
Conservation Division
200 Colorado Derby Building
Wichita, Kansas 67202
(316) 263-3238

OCT 31 1985
10-31-1985
CONSERVATION DIVISION
Wichita, Kansas