

15-173-19051-00-00


H-27-2E

WELL LOG BUREAU—KANSAS GEOLOGICAL SOCIETY
508 East Murdock, Wichita, Kansas

Company. H. H. BLAIR
Farm. Reed No. 2

SEC. 11 T. 27 R. 2E
NE NW NW

Total Depth. 3310'
Comm. 5-26-61 Comp. 6-6-61
Shot or Treated.
Contractor. Red Drlg. Co.
Issued. 7-8-61

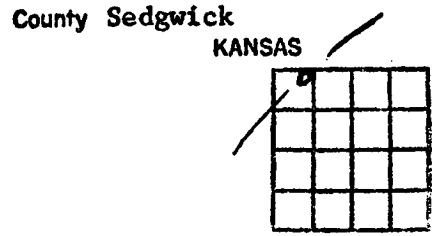

CASING:

8 5/8" 147' cem w/115 sx.

Elevation. 1373'

Production. Dry

Figures indicate Bottom of Formations.

clay	15
lime, sand & clay	147
lime & shale	180
lime & shale strks	470
lime & shale brks	740
shale & lime	1060
shale & lime shls	1390
shale & lime	1575
lime & shale	1660
shale & lime strks	1770
shale	2059
lime & shale	2308
shale	2436
lime & shale	2885
lime & chert	2962
chert & lime	2975
lime - Miss.	3125
shale	3138
shale & lime	3218
lime & sand	3261
shale & sand	3270
sand - Simpson	3283
sand	3300
sand	3307
lime - Arbuckle	3310
Total Depth	

TOPS: SCOUT	
Lansing	2060
Kansas City	2436
Mississippi	2887
Kinderhook	3141
Viola	3191
Upper Simpson	3215
Lower Simpson	3283
Arbuckle	3306