

15-065-21339-00-00


STATE OF KANSAS
STATE CORPORATION COMMISSION

WELL PLUGGING RECORD

Give All Information Completely
Make Required Affidavit
Mail or Deliver Report to
Conservation Division
State Corporation Comm.
245 North Water
Wichita, KS 67202

Graham County, Sec. 14 Twp. 8S Rge. 22 E/W
Location as "NE/CNW $\frac{1}{4}$ SW $\frac{1}{4}$ " or footage from lines

NE NW SW
Lease Owner Paragon Resources, Inc.
Lease Name South Harmony Prospect (Faulkner) No. 1
Office Address 1200 The Main Bldg., 12th Floor, Houston, Tex.
Character of Well (Completed as Oil, Gas or Dry Hole) 77002

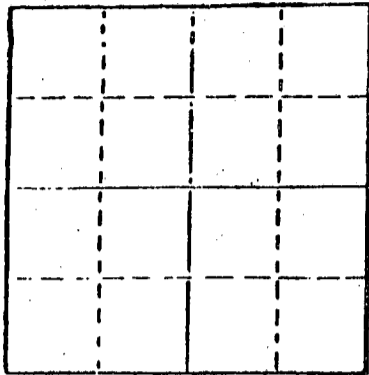

Locate well correctly on above
Section Plot

Dry Hole
Date Well completed 1-4 1981
Application for plugging filed 1-4-1981
Application for plugging approved 1-4 1981
Plugging commenced 1-4 1981
Plugging completed 1-4 1981
Reason for abandonment of well or producing formation

Dry Hole
If a producing well is abandoned, date of last production 19

Was permission obtained from the Conservation Division or its agents before plugging was commenced? yes

Name of Conservation Agent who supervised plugging of this well Gilbert Balthazor
Producing formation _____ Depth to top _____ Bottom _____ Total Depth of Well _____
Show depth and thickness of all water, oil and gas formations.

OIL, GAS OR WATER RECORDS

CASING RECORD

FORMATION	CONTENT	FROM	TO	SIZE	PUT IN	PULLED OUT
				8-5/8	249.70'	-0-

Describe in detail the manner in which the well was plugged, indicating where the mud fluid was placed and the method or methods used in introducing it into the hold. If cement or other plugs were used, state the character of same and depth placed, from _____ feet to _____ feet for each plug set.

Mud laden fluid 3760' - 249.70'
60 sks cement @ 700'
30 sks cement @ 240'
10 sks cement @ 40'
5 sks cement in rat hole

(If additional description is necessary, use BACK of this sheet)

Name of Plugging Contractor Emphasis Oil Operations

STATE OF Kansas COUNTY OF Russell, ss.
Joe K. Branum (employee of owner) or (owner or operator)
of the above-described well, being first duly sworn on oath, says: That I have knowledge of the facts, statements, and matters herein contained and the log of the above-described well as filed and that the same are true and correct. So help me God.

(Signature) Joe K. Branum
Box 506, Russell, KS 67665
(Address)

SUBSCRIBED AND SWORN TO before me this 9th day of January, 1981

Glenda R. Tiffin
Notary Public.

My commission expires February 6, 1984.



RECEIVED
STATE CORPORATION COMMISSION
1-13-81
JAN 12 1981

15-005-21339-00-00

EMPHASIS OIL OPERATIONS

P. O. Box 506

Russell, Kansas 67665

DRILLERS LOG

OPERATOR: Paragon Resources, Inc.
1200 The Main Bldg.
12th Floor
Houston, Texas 77002

CONTRACTOR: Emphasis Oil Operations
P. O. Box 506
Russell, Kansas 67665

LEASE: South Harmony Prospect (Faulkner)

LOCATION: NE NW SW
Section 14-8S-22W
Graham County, Kansas

WELL: #1

Total Depth: 3760'

Elevation:

Commenced: 12-28-80

Completed: 1-4-81

Casing: 8-5/8" @ 249.70'

Status: Dry Hole

DEPTHS & FORMATIONS

(All measurements from K.B.)

Soil & clay	40	Shale & lime	3240
Shale & sand	1668	Lime & shale	3380
Anhydrite	1697	Lime (R.T.D.)	3760
Shale	2870		

STATE OF KANSAS)
) ss:
COUNTY OF RUSSELL)


I, Joe K. Branum, of Emphasis Oil Operations, state that the above and foregoing is a true and correct log of the above captioned well.

Joe K. Branum

Joe K. Branum

RECEIVED
STATE CORPORATION COMMISSION
1-13-81
JAN 12 1981
CONSERVATION DIVISION
Wichita, Kansas

Subscribed and sworn to before me this 9th day of January, 1981.
My Commission Expires: February 6, 1984.

 **GLEND A. R. TIFFIN**
Russell County, Ks.
My Appt. Exp. 2-6-84

Glenda R. Tiffin

Notary Public