



STATE OF KANSAS
STATE CORPORATION COMMISSION

Give All Information Completely
Make Required Affidavit
Mail or Deliver Report to:
Conservation Division
State Corporation Commission
211 No. Broadway
Wichita, Kansas

WELL PLUGGING RECORD

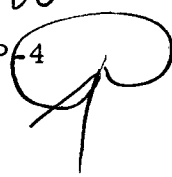

NORTH

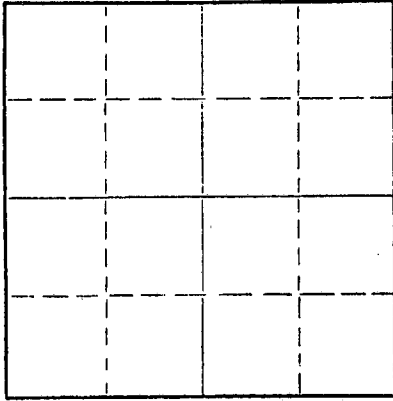

Locate well correctly on above
Section Plat

Sedgwick County, Sec. 7 Twp. 26S Rge. 2 (E) (W)
Location as "NE/CNW/SW" or footage from lines S/2 SE NE
Lease Owner Petroleum, Inc.
Lease Name 888XX Matson C^{sub} Well No. 1
Office Address 352 N. Broadway, Wichita, Kansas
Character of Well (completed as Oil, Gas or Dry Hole) Dry Hole
Date well completed October 1, 1963
Application for plugging filed October 1, 1963
Application for plugging approved October 1, 1963
Plugging commenced October 1, 1963
Plugging completed October 1, 1963
Reason for abandonment of well or producing formation Dry Hole

If a producing well is abandoned, date of last production 19____
Was permission obtained from the Conservation Division or its agents before plugging was commenced? Yes

Name of Conservation Agent who supervised plugging of this well Paul Turpin
Producing formation _____ Depth to top _____ Bottom _____ Total Depth of Well 3020 Feet
Show depth and thickness of all water, oil and gas formations.

OIL, GAS OR WATER RECORDS

CASING RECORD

FORMATION	CONTENT	FROM	TO	SIZE	PUT IN	PULLED OUT
				8 5/8	215'	

Describe in detail the manner in which the well was plugged, indicating where the mud fluid was placed and the method or methods used in introducing it into the hole. If cement or other plugs were used, state the character of same and depth placed, from _____ feet to _____ feet for each plug set.

Hole filled with heavy rotary mud to 185 feet. Bridge at 185 feet with hulls and 20 sacks cement on bridge. Hole filled with heavy rotary mud to 39 feet. Bridge at 39 feet with hulls and 13 sacks cement on bridge. Rat hole capped with 2 sacks cement.

RECEIVED
STATE CORPORATION COMMISSION

OCT 3 1963
10-3-63

CONSERVATION DIVISION
Wichita, Kansas

(If additional description is necessary, use BACK of this sheet)
Name of Plugging Contractor White & Ellis Drilling, Inc. License #209
Address Box 448, El Dorado, Kansas

STATE OF Kansas COUNTY OF Butler, ss.
Ernest Sifford, employee of Contractor (~~employee of owner~~) of the above-described well, being first duly sworn on oath, says: That I have knowledge of the facts, statements, and matters herein contained and the log of the above-described well as filed and that the same are true and correct. So help me God.

(Signature) Ernest Sifford
Box 448, El Dorado, Kansas
(Address)

SUBSCRIBED AND SWORN to before me this 2nd day of October, 1963

My commission expires

September 26, 1964

L. B. Auer
L. B. Auer

Notary Public.

Casing Record

8 5/8

215' Cemented
w/125 sacks

Location: S/2 SE NE
Section: 7-26S-2E
Sedgwick County, Kansas
Farm: Matson "C"-1
Well Owner: Petroleum, Inc.
Contractor: White & Ellis Drig., Inc.
Spudded: 9/21/63
Under Surface: 9/24/63
Completed: 10/1/63



T. D.

3020' ✓

Kelly bushing measurement 5' above ground level.

FORMATION	DEPTH
Soil	0-3
Lime	15
Red rock	20
Shale	80
Shale & Shells	150
Lime	165
Shale	190
Lime	200
Shale	210
Lime	215
Lime & Shale	655
Lime	1020
Shale	1330
Shale & Lime	1660
Lime & Shells	1800
Shale & Lime	2343
Lime	2397
Shale	2436
Lime	2468
Shale	2556
Lime	2700
Shale	2760
Lime	2778
Shale & Lime	2987
Sand & Shale	2989
Sand	2992
Lime	3020

RECEIVED
STATE CORPORATION COMMISSION

OCT 3 1963

CONSERVATION DIVISION
Wichita, Kansas

TOPS

Kansas City 2556

Dry Hole

Mississippi 2992

Plugged & Abandoned