


STATE OF KANSAS
STATE CORPORATION COMMISSION

Give All Information Completely
Make Required Affidavit
Mail or Deliver Report to
Conservation Division
State Corporation Comm.
245 North Water
Wichita, KS 67202

WELL PLUGGING RECORD

Sedgwick County. Sec. 13 Twp. 28S Rge. 2E
Location as "NE/CNW/SW" or footage from lines
5/2 NW/4
Lease Owner Myrl Kelly
Lease Name Scott Well No. 1
Office Address 2659 N. Peasling Ct. Wichita, KS
Character of Well (Completed as Oil, Gas or Dry Hole) Oil
Date Well completed 12-21 1977
Application for plugging filed 9-8 1980
Application for plugging approved 9-12 1980
Plugging commenced 9-22 1980
Plugging completed 9-24 1980
Reason for abandonment of well or producing formation

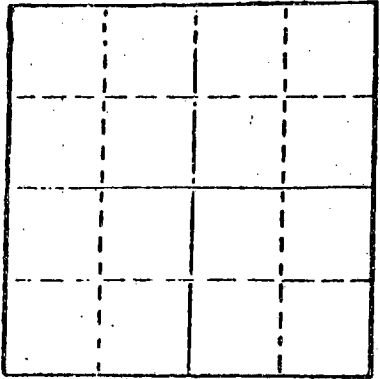

Locate well correctly on above Section Plot

If a producing well is abandoned, date of last production 19__
Was permission obtained from the Conservation Division or its agents before plugging was commenced? Yes

Name of Conservation Agent who supervised plugging of this well DON THOMPSON
Producing formation _____ Depth to top 2200' Bottom 2210' Total Depth of Well 2280'
Show depth and thickness of all water, oil and gas formations.

OIL, GAS OR WATER RECORDS

CASING RECORD

FORMATION	CONTENT	FROM	TO	SIZE	PUT IN	PULLED OUT
				8 5/8"	201'	- 0 -
				5 1/2"	3279'	1785'

Describe in detail the manner in which the well was plugged, indicating where the mud fluid was placed and the method or methods used in introducing it into the hold. If cement or other plugs were used, state the character of same and depth placed, from _____ feet to _____ feet for each plug set.

9-22-80 Rigger up, Dug cellar, Set Bottom Plug at 2100' + 15" sand bridge, + 5 SACKS PORTLAND. Tacked & worked pipe
9-23-80 Set JACKS & Floor. Shot off at 1785' worked pipe loose. Layed 12 JTs down. 9-24-80 Layed casing down. Talled, Tore floor down. Set Top Plug at 215', + 15" rock bridge bailed out 40' of Mud. filled to Top with ready mix.

(If additional description is necessary, use BACK of this sheet)

Name of Plugging Contractor TAWANDA Well Service INC.

STATE OF KANSAS COUNTY OF Butler, ss.
Donald L. Simmons (employee of owner) or (owner or operator)


of the above-described well, being first duly sworn on oath, says: That I have knowledge of the facts, statements, and matters herein contained and the log of the above-described well as filed and that the same are true and correct. So help me God.

(Signature) Lewis C. Wilson
608 Main, Edwardsville, MO 67144
(Address)

rec'd
9-29-80

SUBSCRIBED AND SWORN TO before me this 26th day of September, 1980

Robert L. Simmons
Notary Public.

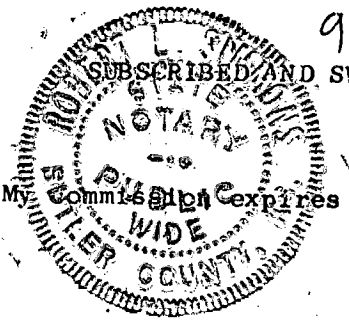

My Commission Expires July 17th 1984

DRILLERS LOG

OPERATOR: Myrl Kelly; 2659 North Pershing Court; Wichita, Kansas 67220

CONTRACTOR: **White & Ellis Drilling, Inc., Box 448, El Dorado, Kansas 67042**

Lease Name Scott Well No. 1

Sec. 13 T. 28 R. 2E Spot S/2 NW/4

County Sedgwick State Kansas Elevation _____

Casing Record:

Surface: 8 5/8" @ 201' with 75 Sxs.

Production: 5 1/2" @ 3279' with 240 Sxs.

Type Well: Oil Total Depth 3280' K.B.

Drilling Commenced: 12-16-77 Drilling Completed 12-21-77

Formation	From	To	Tops
Cellar	0	7	Kansas City 2470
Shale & Lime (Stks)	7	480	Conglomerate 3276
Shale & Lime	480	790	
Shale & Lime (Stks)	790	1550	
Shale & Lime	1550	2139	
Lime	2139	2272	
Shale	2272	2440	
Shale & Lime	2440	2470	
Lime	2470	2700	
Lime & Shale	2700	2870	
Lime & Shale (Stks)	2870	3004	
Shale & Lime	3004	3276	
Sand	3276	3280	

RECEIVED
STATE CORPORATION COMMISSION

SEP 11 1980

CONSERVATION DIVISION
Wichita, Kansas

COMPLETION RECORD

Liner Record: Size _____ From _____ To _____

Cementing Record: _____ Sacks _____

Perforating Record:

Formation	Perforated Interval	Number Shots

Initial Production: _____

Electric Log _____ Type and Depths Covered _____