

STATE OF KANSAS
STATE CORPORATION COMMISSION

WELL PLUGGING RECORD

Give All Information Completely
Make Required Affidavit
Mail or Deliver Report to:
Conservation Division
State Corporation Commission
800 Bittling Building
Wichita, Kansas

Sedgwick

County. Sec. 2 Twp 27S Rge 2E (E) (W)

Location as "NE/CNW $\frac{1}{4}$ SW $\frac{1}{4}$ " or footage from lines SW SW NW

Lease Owner A. D. Allison et al

Lease Name Dysart Well No. 1

Office Address 716 Brown Building, Wichita, Kansas

Character of Well (completed as Oil, Gas or Dry Hole) Dry hole

Date well completed 9-16 1951

Application for plugging filed " 19

Application for plugging approved " 19


Plugging commenced " 19

Plugging completed " 19

Reason for abandonment of well or producing formation Dry hole

If a producing well is abandoned, date of last production 19

Was permission obtained from the Conservation Division or its agents before plugging was commenced? Yes

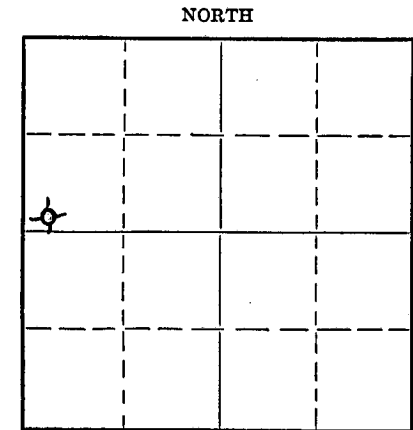

Locate well correctly on above Section Plat

Name of Conservation Agent who supervised plugging of this well D. C. Lilley

Producing formation Depth to top Bottom Total Depth of Well 3360 Feet

Show depth and thickness of all water, oil and gas formations.

OIL, GAS OR WATER RECORDS

CASING RECORD

| Formation | Content | From | To | Size | Put In | Pulled Out |
|-----------|---------|------|----|-------|--------|------------|
| Sand | Water | | 40 | 8-5/8 | 117' | |
| | | | | | | |
| | | | | | | |
Describe in detail the manner in which the well was plugged, indicating where the mud fluid was placed and the method or methods used in introducing it into the hole. If cement or other plugs were used, state the character of same and depth placed, from feet to feet for each plug set.

Filled hole with heavy mud. Pushed bottom plug to 125 feet. Cemented with 15 sacks cement. Filled hole to within 10 feet of top with heavy mud. Set top plug and cemented with 5 sacks cement.

STATE OF KANSAS
9-18-51
SEP 18 1951
CONSERVATION DIVISION

(If additional description is necessary, use BACK of this sheet)

Correspondence regarding this well should be addressed to A. D. Allison & Co., Inc.,
Address 716 Brown Building, Wichita 2, Kansas.


STATE OF Kansas, COUNTY OF Sedgwick, ss.

J. A. ALLISON (employee of owner) or (owner or operator) of the above-described well, being first duly sworn on oath, says: That I have knowledge of the facts, statements, and matters herein contained and the log of the above-described well as filed and that the same are true and correct. So help me God.

(Signature) J. A. Allison
716 Brown Building, Wichita 2, Kansas
(Address)

SUBSCRIBED AND SWORN to before me this 17th day of September, 1951.

My commission expires 7-22-53 Notary Public.

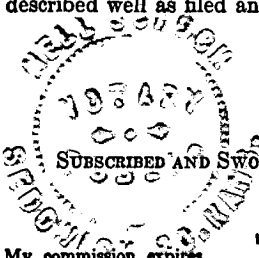

PLUGGING
FILE SEC 2 T 27 R 2 E
BOOK PAGE 10 LINE 6

A. D. ALLISON
#1 Dysart

Sec. 2, Twp. 27S., Rge. 2E.,
Sedgwick County, Kansas.

Total Depth: 3360'

Comm: 9-1-51

Comp: 9-16-51

CONTR: A. D. ALLISON & CO., INC., D & A

Issued: 9-17-51

SW SW NW

CASING RECORD:

8-5/8 117'

FORMATION

DEPTH

| | |
|------------------------|--------------|
| Clay and sand | 40 |
| Shale | 85 |
| Lime | 95 |
| Hard lime | 117 |
| Lime | 220 |
| Lime and shale | 365 |
| Lime and shale streaks | 460 |
| Shale and shells | 565 |
| Lime and shale | 735 |
| Shale and shells | 1455 |
| Lime and shale | 1655 |
| Shale and lime streaks | 1830 |
| Shale and lime | 1970 |
| Lime and shale | 2150 |
| Lime | 2210 |
| Shale | 2245 |
| Hard lime | 2270 |
| Shale | 2280 |
| Lime | 2315 |
| Lime and shale | 2400 |
| Shale | 2445 |
| Lime and shale streaks | 2475 |
| Lime | 2705 |
| Lime and shale | 2770 |
| Shale | 2906 |
| Chert | 2929 |
| Chat | 2995 |
| Lime | 3072 |
| Lime and shale | 3218 |
| Lime | 3250 |
| Sand | 3350 |
| Lime | 3360 - T. D. |

TOPS:

| | |
|-------------------|------|
| Kansas City | 2445 |
| Mississippi | 2906 |
| Viola | 3215 |
| Crystalline Viola | 3231 |
| Simpson dolomite | 3248 |
| Simpson sand | 3265 |
| Arbuckle | 3345 |

