


STATE OF KANSAS  
STATE CORPORATION COMMISSION

Give All Information Completely  
Make Required Affidavit  
Mail or Deliver Report to:  
Conservation Division  
State Corporation Commission  
800 Blitting Building  
Wichita, Kansas

WELL PLUGGING RECORD  
OR  
FORMATION PLUGGING RECORD

Strike out upper line  
when reporting plug-  
ging off formations.

NORTH

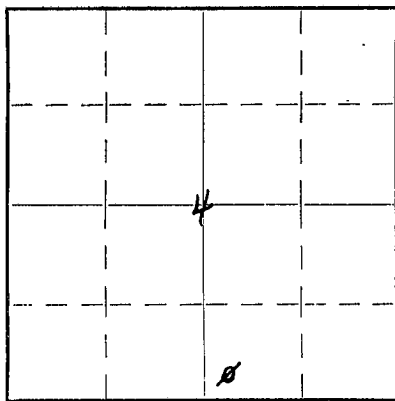

Locate well correctly on above  
Section Plat

Sedgwick County. Sec. 4 Twp. 27 Rge. 2 (E) (W)  
Location as "NE $\frac{1}{4}$ NW $\frac{1}{4}$ SW $\frac{1}{4}$ " or footage from lines SW $\frac{1}{4}$  SE $\frac{1}{4}$   
Lease Owner E. B. Shawver  
Lease Name Charlotte Haass et al Well No. 1  
Office Address 310 Ellis-Singleton Bldg., Wichita, Kansas  
Character of Well (Completed as Oil, Gas or Dry Hole) dry  
Date, well completed Oct. 10 1938  
Application for plugging filed Oct. 10 1938  
Application for plugging approved Oct. 11 1938  
Plugging Commenced Oct. 10 1938  
Plugging Completed Oct. 11 1938  
Reason for abandonment of well or producing formation  
If a producing well is abandoned, date of last production 193      
Was permission obtained from the Conservation Division or its agents before plugging was commenced?  
yes

Name of Conservation Agent who supervised plugging of this well T. R. Johns  
Producing formation Depth to top Bottom Total Depth of Well Feet.  
Show depth and thickness of all water, oil and gas formations.



OIL, GAS OR WATER RECORDS

CASING RECORD

Formation	Content	From	To	Size	Put In	Pulled Out
				12 $\frac{1}{2}$ "	120	none
				8 $\frac{1}{2}$ "	2950	2000'
				7"	3200	3200'

Describe in detail the manner in which the well was plugged, indicating where the mud fluid was placed and the method or methods used in introducing it into the hole. If cement or other plugs were used, state the character of same and depth placed, from feet to feet for each plug set.

Hole mudded from 3303' to 3200'. Pulled 7" casing and mudded hole to 2950'. Set bridge at 2950' and put in 15 sacks of cement. Pumped mud on top of bridge to 120'. Set bridge, put in 15 sacks of cement, and pumped in mud to top. Cemented top with 15 sacks.

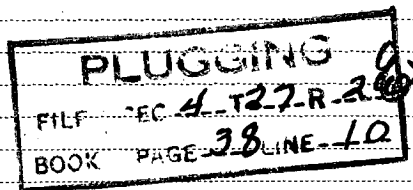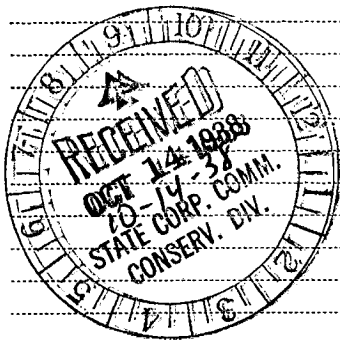

(If additional description is necessary, use BACK of this sheet)

Correspondence regarding this well should be addressed to E. B. Shawver  
Address Wichita, Kansas

STATE OF Kansas COUNTY OF Sedgwick, ss.  
Sedgwick C. R. Grove (employee of owner) ~~or (owner or operator)~~ of the above-described well, being first duly sworn on oath, says: That I have knowledge of the facts, statements, and matters herein contained and the log of the above-described well as filed and that the same are true and correct. So help me God.

(Signature) C. R. Grove  
Route #6, Wichita, Kansas  
(Address)

SUBSCRIBED AND SWORN to before me this 12th day of October, 1938

My commission expires Dec. 16, 1941  
Amy L Jones Notary Public.

L O G

E. B. SHAWVER

Farm: Charlotte Haass et al well #1  
 Location: SWc SW $\frac{1}{4}$  SE $\frac{1}{4}$  Sec. 4-27S-2E, Sedgwick County

Drilling Commenced: August 30, 1938

Drilling Completed: October 10, 1938

Contractor: E. B. Shawver

Elevation: 1380'

sand	55	lime	2930
salt lime	70	V. C. shale	2935
shale	78	lime shell	2937
lime	90	V. C. shale	2950
shale	110	chat	2966
lime	117	cherty lime	2975
shale	160	chat	2991
shale & shells	215	lime	2999
lime	250	chat	3002
shale	280	lime	3048
lime	325	chert	3053
shale	335	lime	3144
lime	425	lime hard	3149
shale	475	lime	3161
lime	525	shale green	3173
shale	545	lime	3174
lime	555	corrected measurement:	
shale	580	3174 equals	3181
red rock	595	shale	3188
shale & shells	650	lime	3219
lime	750	shale black	3264 $\frac{1}{2}$
shale	1020	Misener sand	3265 $\frac{1}{2}$
shale & shells	1117	Misener dolomite	3767 $\frac{1}{2}$
shale	1125	Viola lime	3300
lime	1132	sand	3305
shale	1170	Total Depth	3305
shale & shells	1240		
lime	1270		
shale & shells	1339		
shale	1450		
lime	1480		
shale	1500		
lime	1525		
shale	1556		
lime	1712		
shale	1852		
lime	1908		
shale	1930		
lime	1965		
shale	1995		
shale sandy	2046		
shale	2125		
lime	2225		
lime sandy	2266		
lime	2319		
shale	2325		
lime	2355		
shale	2417		
shale & shells	2448		
shale	2480		
K.C. lime	2547		
shale	2556		
lime	2658		
shale	2735		
lime	2769		
shale	2840		
lime	2886		
shale & shells	2915		

Drilled to 2950 with rotary tools and standardized.

Water record:

water	2975-79
HPW	3015-30
HPW	3268

Casing Record:

12 $\frac{1}{2}$ "	125' left in (cemented)
8- $\frac{3}{4}$ "	2950' cemented
6- $\frac{5}{8}$ "	3200'

Dry & Abandoned

