


STATE OF KANSAS
STATE CORPORATION COMMISSION

WELL PLUGGING RECORD

Give All Information Completely
Make Required Affidavit
Mail or Deliver Report to:
Conservation Division
State Corporation Commission
800 Bitting Building
Wichita, Kansas

Sedgwick County, Sec. 5 Twp 27S Rge. 2E (E) (W)
Location as "NE/CNW/SW" or footage from lines SE SE SE
Lease Owner: Crest Drilling Co. etal
Lease Name Wheeler Well No. 1
Office Address 600 Petroleum Bldg., Wichita, Kansas
Character of Well (completed as Oil, Gas or Dry Hole) dry hole
Date well completed June 11, 1952
Application for plugging filed June 11, 1952
Application for plugging approved June 11, 1952
Plugging commenced June 11, 1952
Plugging completed June 11, 1952
Reason for abandonment of well or producing formation dry hole

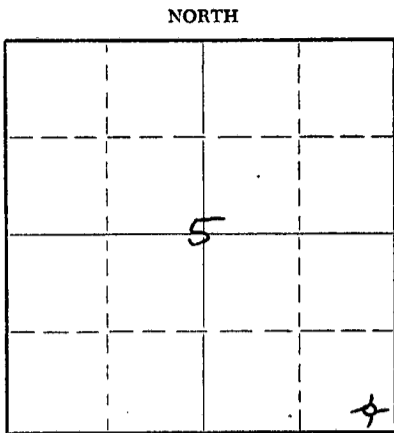

Locate well correctly on above
Section Plat

If a producing well is abandoned, date of last production _____ 19____
Was permission obtained from the Conservation Division or its agents before plugging was commenced? yes

Name of Conservation Agent who supervised plugging of this well D. C. Lilley
Producing formation _____ Depth to top _____ Bottom _____ Total Depth of Well 3415 Feet
Show depth and thickness of all water, oil and gas formations.

OIL, GAS OR WATER RECORDS

CASING RECORD

FORMATION	CONTENT	FROM	TO	SIZE	PUT IN	PULLED OUT
				8-5/8"	91 ft	None

Describe in detail the manner in which the well was plugged, indicating where the mud fluid was placed and the method or methods used in introducing it into the hole. If cement or other plugs were used, state the character of same and depth placed, from top feet to bottom feet for each plug set.

Mud from 3415 feet to 125 feet. Set plug at 125 and dumped 25 sacks of cement. Mud to 5 feet and cement to cap. Steel cap welded on top.

(If additional description is necessary, use BACK of this sheet)

Name of Plugging Contractor Crest Drilling Co.
Address 600 Petroleum Bldg., Wichita, Kansas

STATE OF Kansas, COUNTY OF Sedgwick, ss.
W. W. Wright (employee of owner) or (owner or operator) of the above-described well, being first duly sworn on oath, says: That I have knowledge of the facts, statements, and matters herein contained and the log of the above-described well as filed and that the same are true and correct. So help me God.

(Signature) [Signature]
600 Petroleum Bldg., Wichita, Kansas
(Address)

Subscribed and sworn to before me this 14th day of June, 19 52
My commission expires January 19, 1955.

Annette O. Kennally
RECEIVED
STATE CORPORATION COMMISSION
Notary Public.



PLUGGING
FILE SEC 5 T 27 R 26
BOOK PAGE 2 LINE 33

JUL 19 1952
7-19-52
CONSERVATION DIVISION
Wichita, Kansas

COMPANY: Crest Drilling Co. et al
 CONTRACTOR: Crest Drilling Co.
 FARM: Wheeler No. 1
 LOCATION: SE, SE, SE, Section 5-27S-2E,
 Sedgwick County, Kansas

COMMENCED: May 29, 1952
 COMPLETED: June 11, 1952

ELEVATION: 1393 D.F. (1390 Gr)

All measurements from rotary bushing
 2 1/2 feet above derrick floor

CASING RECORD: 8-5/8" cemented @ 86 feet
 w/ 75 sacks

<u>FORMATION</u>	<u>DEPTH</u>
Surface soil	15
Lime	50
Lime - shale	80
Water sand	84
Lime	86
Lime - shale	210
Lime - shale	115
Lime	585
Lime - shale	755
Shale - lime	1600
Lime & sandy shale	1915
Lime - shale	2350
Lime - sandy shale	2415
Shale	2475
Shale & K. C. Lime	2555
Lime - shale	2635
Lime	2670
Shale	2820
Lime - shale	2905
Shale - lime	2955
Lime - Miss.	3080
Lime - Miss.	3182
Lime - shale	3285
Viola lime	3310
Viola - sand	3347
Simpson Sand - shale	3395
Shale - lime	3415 T. D.

D & A

Top: Mississippi lime	2950
Viola lime	3291
Simpson Sand	3311
Arbuckle lime	3398

I hereby certify that this is a true and correct record and log of the well drilled on the above-mentioned location to the best of my knowledge and belief.

CREST DRILLING CO.

By

[Handwritten Signature]

STATE OF KANSAS

COUNTY OF SEDGWICK

PLUGGING
 FILE SEC 5-27-2E
 BOOK PAGE 25 LINE 3

Subscribed and sworn to before me, a notary public, within and for the state county above, this 11th day of June, 1952.

Annette A. Kennalley
 RECEIVED Public
 STATE CORPORATION COMMISSION

JUL 19 1952

CONSERVATION DIVISION
 Wichita, Kansas

Commission Expires:

January 19, 1955.