


STATE OF KANSAS  
STATE CORPORATION COMMISSION

Give All Information Completely  
Make Required Affidavit  
Mail or Deliver Report to:  
Conservation Division  
State Corporation Commission  
211 No. Broadway  
Wichita, Kansas

WELL PLUGGING RECORD

NORTH

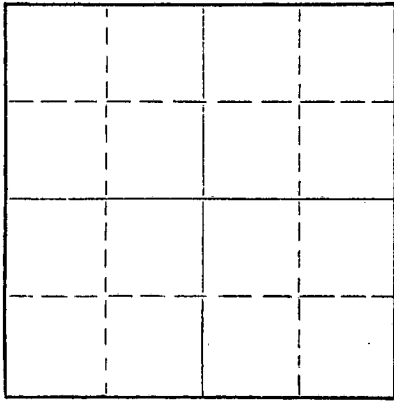

Locate well correctly on above  
Section Plat

Butler County. Sec. 26 Twp. 27 Rge. 3 (E) (W)  
Location as "NE/CNW/SW" or footage from lines NW 1/4 NW 1/4 NW 1/4  
Lease Owner Associated Co. Inc  
Lease Name Scully Well No. 1  
Office Address 1441 McLean Blvd., S., Wichita, Kans.  
Character of Well (completed as Oil, Gas or Dry Hole) DRY HOLE  
Date well completed July 20, 19 9  
Application for plugging filed July 20 19 9  
Application for plugging approved 19 9  
Plugging commenced July 20 19 9  
Plugging completed July 20 19 9  
Reason for abandonment of well or producing formation dry

If a producing well is abandoned, date of last production \_\_\_\_\_ 19 \_\_\_\_  
Was permission obtained from the Conservation Division or its agents before plugging was commenced? Yes

Name of Conservation Agent who supervised plugging of this well Lee Guthrie  
Producing formation \_\_\_\_\_ Depth to top \_\_\_\_\_ Bottom \_\_\_\_\_ Total Depth of Well 2840 Feet  
Show depth and thickness of all water, oil and gas formations.


OIL, GAS OR WATER RECORDS

CASING RECORD

FORMATION	CONTENT	FROM	TO	SIZE	PUT IN	PULLED OUT
<u>Miss</u>	<u>dry</u>	<u>2816</u>	<u>2840</u>			

Describe in detail the manner in which the well was plugged, indicating where the mud fluid was placed and the method or methods used in introducing it into the hole. If cement or other plugs were used, state the character of same and depth placed, from \_\_\_\_\_ feet to \_\_\_\_\_ feet for each plug set.

R. T. D. 2840  
Plug 171  
2840-171 Heavy Mud  
171-170 Halliburton plug  
170-95 15 Sx Portland cement  
95- 50 Heavy mud  
50- 49 Halliburton plug  
49-5 10 Sx Portland cement  
Cut 8 5/8" off 5' below ground level  
weld steel plate on surface pipe

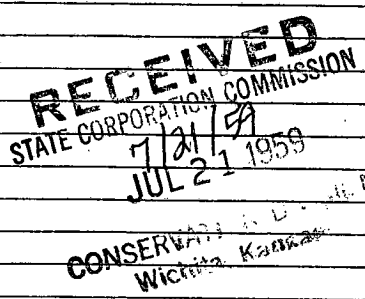

(If additional description is necessary, use BACK of this sheet)  
Name of Plugging Contractor Warren R. Winne  
Address Un. Nat'l Bk. Bldg., Wichita, Kas.

STATE OF KANSAS, COUNTY OF BEDGWICK, ss.  
George Olds (employee of owner) or owner or operator of the above-described well, being first duly sworn on oath, says: That I have knowledge of the facts, statements, and matters herein contained and the log of the above-described well as filed and that the same are true and correct. So help me God.

(Signature) George Olds  
1441 McLean Blvd., Wichita 13, Kansas (Address)

SUBSCRIBED AND SWORN TO before me this 20 day of July  
Phyllis Jean Clark  
Notary Public

My commission expires 4-14-63

PLUGGING  
FILE SEC 26 T. 27 R. 3E  
BOOK PAGE 52 LINE 26



WELL LOG

No. 1 Scully NW NW NW 26, 27S-3E Butler Co., Kans.

Associated Co., Inc., Winne tools

Spudded 7/ 13 July 59  
150' 8 5/8" surf. set 14 July.

Completed D&A July 20, 59

WELL LOG:

<del>Ø 15 Ø</del> soil and shale	150
shale	400
shale and lime	600
lime and limy sh	1000
shale	1360
lime	1425
sand	1435
shale	1551
lime	1585
shale	2325
lime K C	2455
shale	2816
lime Miss	2840

T. D.

No shows no tests

RECEIVED  
STATE CORPORATION COMMISSION

JUL 27 1959

CONSERVATION

Wichita

PLUGGING

FILE SEC. 26 T. 27 R. 3E  
BOOK PAGE 52 LINE 26