

CARD MUST BE TYPED

State of Kansas

CARD MUST BE SIGNED

NOTICE OF INTENTION TO DRILL

(see rules on reverse side)

Starting Date 8 - 4 - 87
month day year

API Number 15- 107-22897-00-00

OPERATOR: License # 5872
Name Thomas Moylan
Address Route 2
City/State/Zip LaCygne, Kansas 66040
Contact Person Thomas Moylan
Phone 913-757-4426

C/102 NW/4 ^{NW} NW/4 Sec. 3 Twp. 20 S, Rg. 24 East
4950 Ft. from South Line of Section
4620 Ft. from East Line of Section

(Note: Locate well on Section Plat on reverse side)

CONTRACTOR: License #
Name Company Tools
City/State

Nearest lease or unit boundary line 330 feet
County Linn

Well Drilled For: Well Class: Type Equipment:
 Oil SWD Infield Mud Rotary
 Gas Inj Pool Ext. Air Rotary
 OWWO Expl Wildcat Cable

Lease Name Nelson Well # N-87-19
Ground surface elevation _____ feet MSL
Domestic well within 330 feet: yes no
Municipal well within one mile: yes no

If OWWO: old well info as follows:
Operator
Well Name
Comp Date Old Total Depth

Depth to bottom of fresh water _____
Depth to bottom of usable water _____
Surface pipe by Alternate: 1 2
Surface pipe planned to be set 40
Conductor pipe required
Projected Total Depth 200 feet
Formation Knobtown

I certify that well will comply with K.S.A. 55-101, et seq., plus eventually plugging hole to KCC specifications.
Date 8-4-87 Signature of Operator or Agent [Signature] Title As Agent


For KCC Use:
Conductor Pipe Required _____ feet; Minimum Surface Pipe Required 20 feet per Alt. 1
This Authorization Expires 2-4-88 Approved By [Signature] 8-4-87

Must be filed with the K.C.C. five (5) days prior to commencing well
This card void if drilling not started within six (6) months of date received by K.C.C.

Important procedures to follow:

1. Notify District office before setting surface casing.
2. Set surface casing by circulating cement to the top.
3. File completion forms ACO-1 with K.C.C. within 90 days of well completion, following instructions on ACO-1, side 1, and including copies of wireline logs.
4. Notify District office 48 hours prior to old well workover or re-entry.
5. Prior to filing Intent, prepare a proposed plugging plan in case well is D & A, then obtain approval of plan when calling district office prior to setting surface pipe.
6. Submit plugging report (CP-4) to K.C.C. after plugging is completed.
7. Obtain an approved injection docket number before disposing of salt water.
8. Notify K.C.C. within 10 days when injection commences or terminates.
9. If an alternate 2 completion, cement in the production pipe from below any usable water to surface within 120 days of spud date.

A Regular Section of Land 1 Mile = 5,280 Ft.

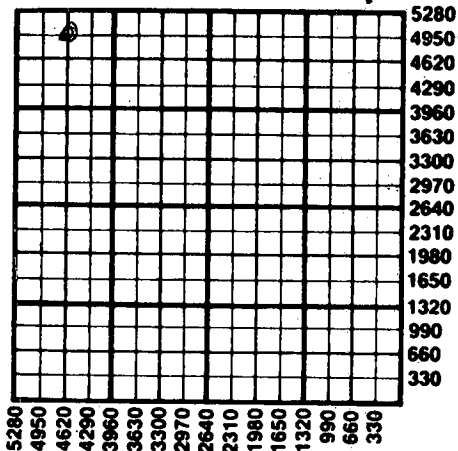

8-4-87

State Corporation Commission of Kansas
Conservation Division
200 Colorado Derby Building
Wichita, Kansas 67202
(313) 288-2700

RECEIVED
STATE CORPORATION COMMISSION
AUG 4 1987
Wichita, Kansas
CONSERVATION DIVISION