

# NOTICE OF INTENTION TO DRILL

(see rules on reverse side)

✓10

Expected Spud Date..... 9 month 27 day 1988 year

API Number 15— 107-23,016-00-00

OPERATOR: License # ..... 5872

NE NW SW Sec. 3 Twp. 20 S, Rg. 24  East  
2310 Ft. from South Line of Section  
4290 Ft. from East Line of Section

Name ..... THOMAS MOYLAN

Address ..... RR #2 Box 48

City/State/Zip ..... LaCygne, Kansas 66040

Contact Person..... Thomas Moylan

Phone..... (913) 757-4426

(Note: Locate well on Section Plat on reverse side)

Nearest lease or unit boundary line ..... 330 feet

County..... LINN

CONTRACTOR: License # .....

Lease Name..... NELSON Well # N88-24

Name ..... COMPANY TOOLS

City/State.....

Ground surface elevation ..... feet MSL

Domestic well within 330 feet: ..... yes  no

Municipal well within one mile: ..... yes  no

Well Drilled For: Well Class: Type Equipment:

Oil  Storage  Infield  Mud Rotary

Gas  Inj  Pool Ext.  Air Rotary

OWWO  Expl  Wildcat  Cable

Depth to bottom of fresh water..... 60

Depth to bottom of usable water ..... 200

Surface pipe by Alternate: ..... 1  2

Surface pipe planned to be set ..... 40

Conductor pipe required ..... None

Projected Total Depth ..... 480 feet

Formation..... Squirrel

If OWWO: old well info as follows:

Operator .....

Well Name .....

Comp Date..... Old Total Depth.....

I certify that well will comply with K.S.A. 55-101, et seq., plus eventually plugging hole to KCC specifications.

Date .... 9-22-88 .... Signature of Operator or Agent [Signature] Title..... Agent.....

For KCC Use:

Conductor Pipe Required ..... feet; Minimum Surface Pipe Required ..... 20' feet per Alt.  2

This Authorization Expires 3-22-89 Approved By LKM 9-22-88

EFFECTIVE DATE: 9-27-88


Must be filed with the K.C.C. five (5) days prior to commencing well.  
This card void if drilling not started within six (6) months of date received by K.C.C.

### Important procedures to follow:

1. Notify District office before setting surface casing.
2. Set surface casing by circulating cement to the top.
3. File completion forms ACO-1 with K.C.C. within 120 days of well spud date, following instructions on ACO-1, side 1, and including copies of wireline logs.
4. Notify District office 48 hours prior to old well workover or re-entry.
5. Prior to filing Intent, prepare a proposed plugging plan in case well is D & A, then obtain approval of plan when calling district office prior to setting surface pipe.
6. Submit plugging report (CP-4) to K.C.C. after plugging is completed.
7. Obtain an approved injection docket number before disposing of salt water.
8. Notify K.C.C. within 10 days when injection commences or terminate.
9. If an alternate 2 completion, cement in the production pipe from below any usable water to surface within 120 days of spud date.

### A Regular Section of Land 1 Mile = 5,280 Ft.

# 24

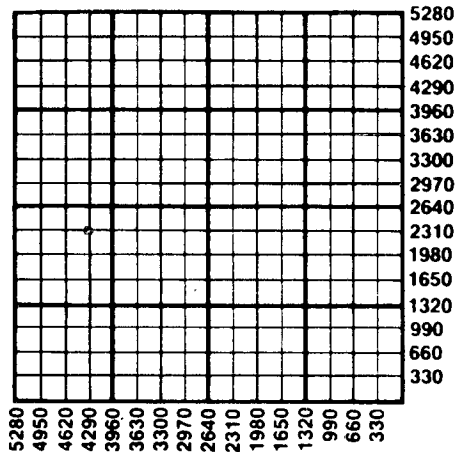

RECEIVED  
STATE CORPORATION COMMISSION

SEP 22 1988

CONSERVATION DIVISION  
Wichita, Kansas

9-22-88

State Corporation Commission of Kansas  
Conservation Division  
200 Colorado Derby Building  
Wichita, Kansas 67202-1212  
(316) 263-3238