

CARD MUST BE TYPED

State of Kansas

CARD MUST BE SIGNED

NOTICE OF INTENTION TO DRILL

(see rules on reverse side)

Expected Spud Date..... 9 month 27 day 1988 year

API Number 15-107-23, 017-0000

OPERATOR: License #..... 5872

Name..... THOMAS MOYLAN

Address..... RR #2 Box 48

City/State/Zip..... LaCygne, Kansas 66040

Contact Person..... Thomas Moylan

Phone..... (913) 757-4426

CONTRACTOR: License #.....

Name..... COMPANY TOOLS

City/State.....

Well Drilled For: Well Class: Type Equipment:

___ Oil ___ Storage X Infield ___ Mud Rotary

X Gas ___ Inj ___ Pool Ext. X Air Rotary

___ OWWO ___ Expl ___ Wildcat ___ Cable

If OWWO: old well info as follows:

Operator.....

Well Name.....

Comp Date..... Old Total Depth.....

I certify that well will comply with K.S.A. 55-101, et seq., plus eventually plugging hole to KCC specifications.

Date..... 9-22-88 Signature of Operator or Agent..... Title..... Agent.....

For KCC Use:

Conductor Pipe Required..... feet; Minimum Surface Pipe Required..... 20' feet per Alt. X (2)

This Authorization Expires..... 3-22-89 Approved By..... 9-22-88

EFFECTIVE DATE: 9-27-88

SE. NW. SW. Sec... 3... Twp... 20 S, Rg... 24 X East
1650 Ft. from South Line of Section
4290 Ft. from East Line of Section

(Note: Locate well on Section Plat on reverse side)

Nearest lease or unit boundary line..... 990 feet

County..... LINN

Lease Name..... NELSON Well # N88-25

Ground surface elevation..... feet MSL

Domestic well within 330 feet: ___ yes X no

Municipal well within one mile: ___ yes X no

Depth to bottom of fresh water..... 60

Depth to bottom of usable water..... 200

Surface pipe by Alternate: 1 ___ 2 X

Surface pipe planned to be set..... 40

Conductor pipe required..... None


Projected Total Depth..... 480 feet

Formation..... Squirrel

Must be filed with the K.C.C. five (5) days prior to commencing well
This card void if drilling not started within six (6) months of date received by K.C.C.

Important procedures to follow:

1. Notify District office before setting surface casing.
2. Set surface casing by circulating cement to the top.
3. File completion forms ACO-1 with K.C.C. within 120 days of well spud date, following instructions on ACO-1, side 1, and including copies of wireline logs.
4. Notify District office 48 hours prior to old well workover or re-entry.
5. Prior to filing Intent, prepare a proposed plugging plan in case well is D & A, then obtain approval of plan when calling district office prior to setting surface pipe.
6. Submit plugging report (CP-4) to K.C.C. after plugging is completed.
7. Obtain an approved injection docket number before disposing of salt water.
8. Notify K.C.C. within 10 days when injection commences or terminates.
9. If an alternate 2 completion, cement in the production pipe from below any usable water to surface within 120 days of spud date.

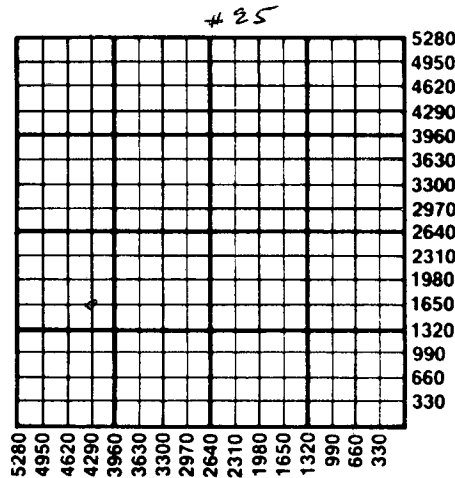

RECEIVED
STATE CORPORATION COMMISSION
STATE CORPORATION COMMISSION

SEP 27 1980

State Corporation Commission of Kansas

CONSERVATION DIVISION
Wichita, Kansas

Conservation Division
200 Colorado Derby Building
Wichita, Kansas 67202-1212

(316) 263-3238

9-22-88