

CARD MUST BE TYPED

State of Kansas

CARD MUST BE SIGNED

# NOTICE OF INTENTION TO DRILL

(see rules on reverse side)

Expected Spud Date: 8-3-87  
month day year

API Number 15- 107-22,894-0000

OPERATOR: License # 6157  
Name J. & J. Oil Company  
Address Box 298  
City/State/Zip Mound City, Kansas 66056  
Contact Person Paul Jackson  
Phone 913-795-2586

N East  
E West  
1/4 Sec. 10 Twp. 20 S, Rg 23  
3795 Ft. from South Line of Section  
1485 Ft. from East Line of Section

(Note: Locate well on Section Plat on reverse side)

CONTRACTOR: License # 6157  
Name Company Tools  
City/State Mound City, Kansas 66056

Nearest lease or unit boundary line 1485 feet  
County Linn

Well Drilled For: Well Class: Type Equipment:  
 Oil  Storage  Infield  Mud Rotary  
 Gas  Inj  Pool Ext.  Air Rotary  
 OWWO  Expl  Wildcat  Cable

Lease Name Person Well # PMI-1  
Ground surface elevation N/A feet MSL

Domestic well within 330 feet:  yes  no  
Municipal well within one mile:  yes  no

Depth to bottom of fresh water 60'

Depth to bottom of usable water 150'

Surface pipe by Alternate: 1  2

Surface pipe planned to be set 21'

Conductor pipe required None

Projected Total Depth 236' feet

Formation Peru

If OWWO: old well info as follows:

Operator .....

Well Name .....

Comp Date ..... Old Total Depth .....

I certify that well will comply with K.S.A. 55-101, et seq., plus eventually plugging hole to KCC specifications.

Date 7-24-87 Signature of Operator or Agent Paul Jackson Title Owner

For KCC Use:

Conductor Pipe Required ..... feet; Minimum Surface Pipe Required ..... 20 feet per Alt. X 2


This Authorization Expires 1-27-88 Approved By PH 7-27-87

Must be filed with the K.C.C. five (5) days prior to commencing well  
This card void if drilling not started within six (6) months of date received by K.C.C.

**Important procedures to follow:**

1. Notify District office before setting surface casing.
2. Set surface casing by circulating cement to the top.
3. File completion forms ACO-1 with K.C.C. within 120 days of well spud date, following instructions on ACO-1, side 1, and including copies of wireline logs.
4. Notify District office 48 hours prior to old well workover or re-entry.  
Prior to filing Intent, prepare a proposed plugging plan in case well is D & A, then obtain approval of plan when calling district office prior to setting surface pipe.  
Submit plugging report (CP-4) to K.C.C. after plugging is completed.  
Obtain an approved injection docket number before disposing of salt water.
8. Notify K.C.C. within 10 days when injection commences or terminates.
9. If an alternate 2 completion, cement in the production pipe from below any usable water to surface within 120 days of spud date.

**A Regular Section of Land**  
1 Mile = 5,280 Ft.

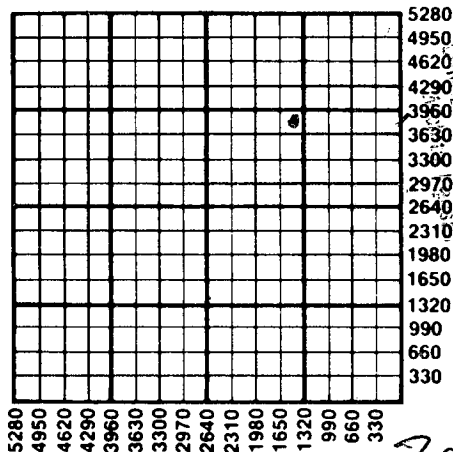

STATE CORPORATION COMMISSION  
RECEIVED  
JUL 27 1987  
CONSERVATION DIVISION

7-27-87

State Corporation Commission of Kansas  
Conservation Division  
200 Colorado Derby Building  
Wichita, Kansas 67202-1212  
(316) 263-3238